


T. 4 S. R. 4 W. W.M.

SECTION 5

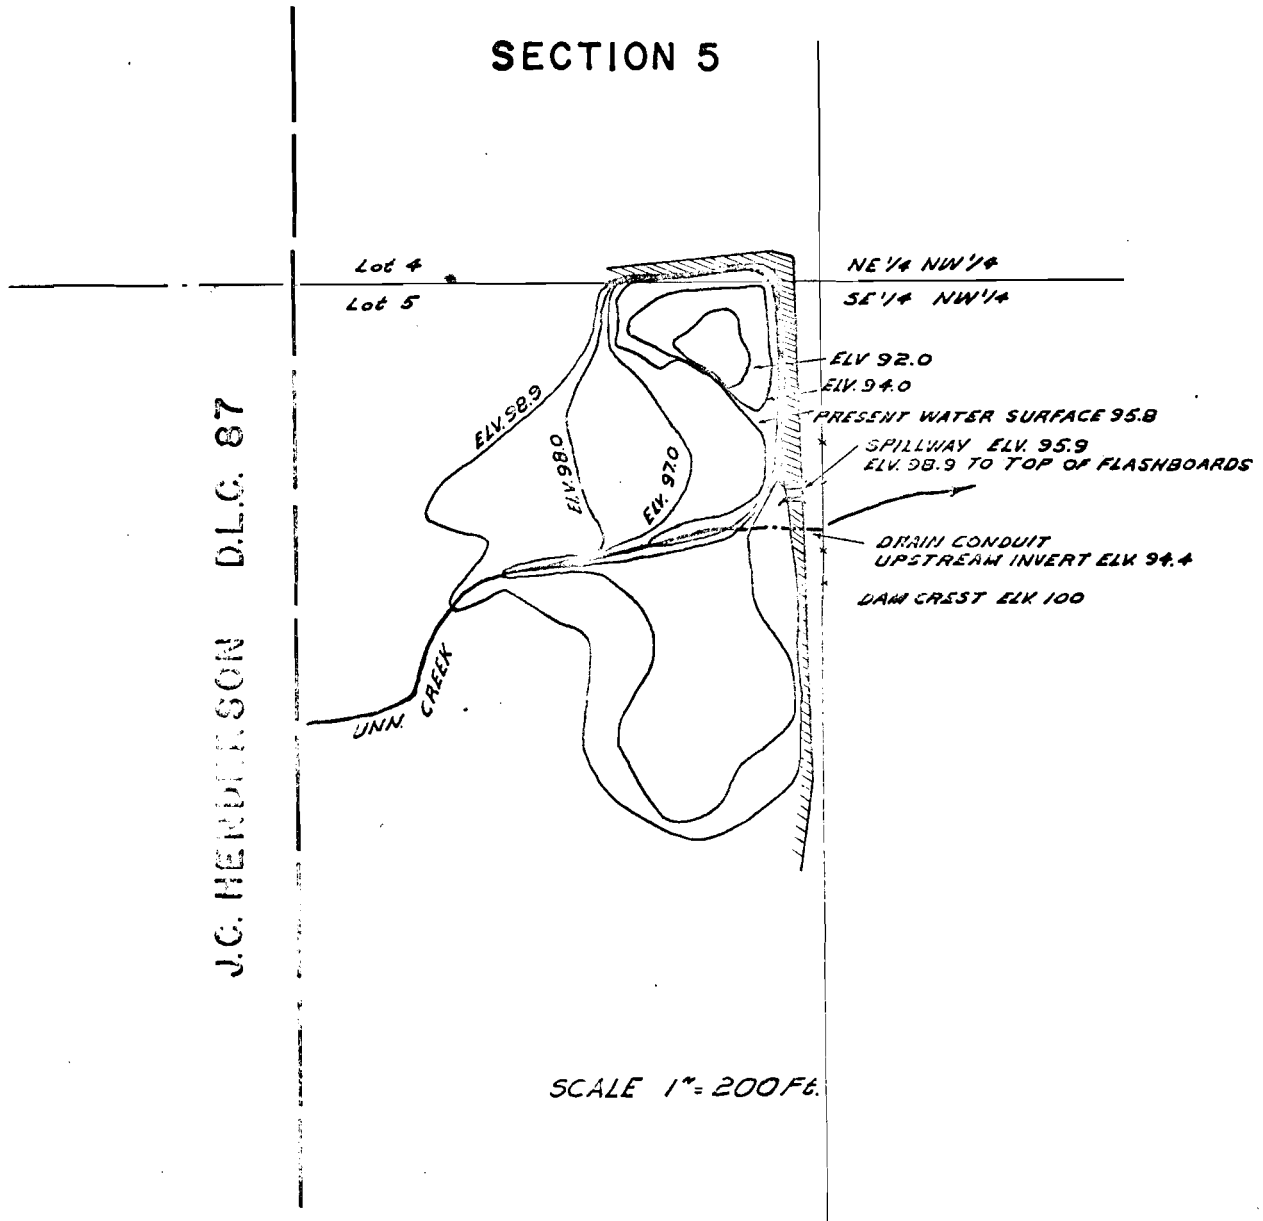

FINAL PROOF SURVEY
UNDER

Application No. R-37190 Permit No. R-2704
IN NAME OF

FRANK DONNELLY

Surveyed APR. 26 1965, by M. BROWN