


T.12S.R.5W.W.M.

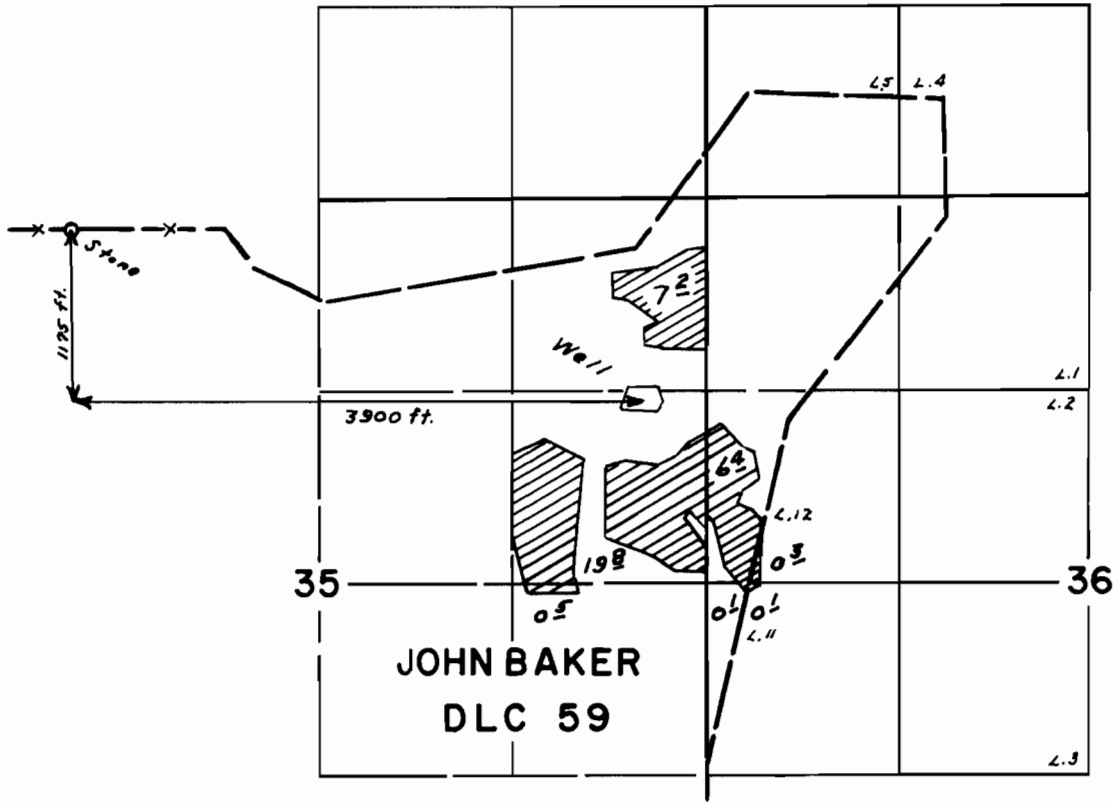

FINAL PROOF SURVEY
UNDER

Application No. G-1448 Permit No. G-1334
IN NAME OF
C. E. JONES

Surveyed Sept. 28, 29, 1965, by *Clayton Anderson*