


T.12S.R.5W. W.M.

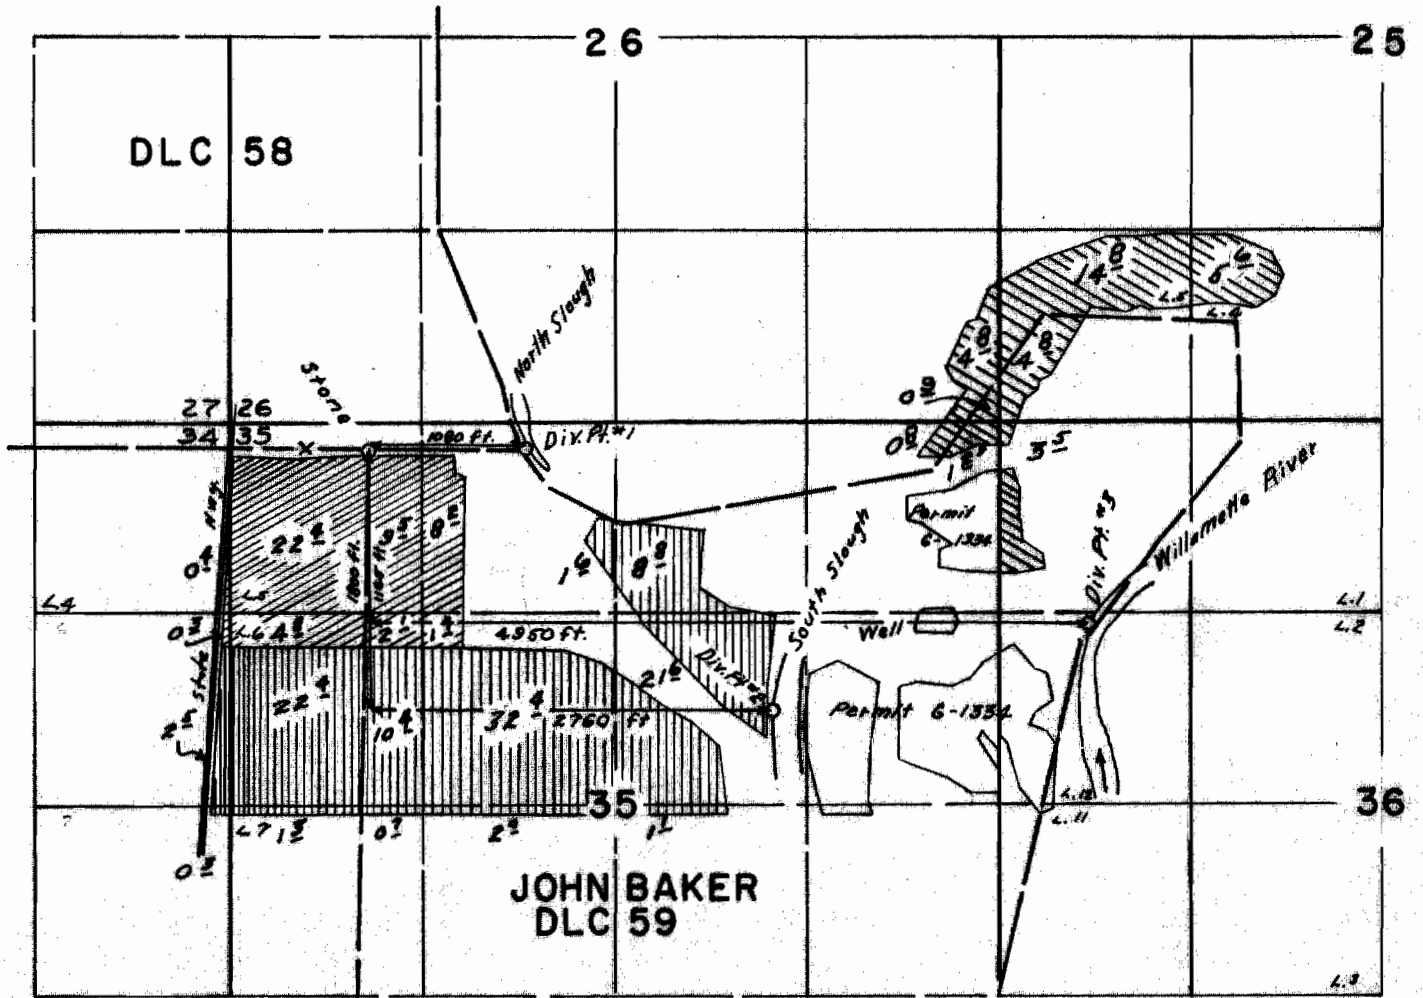

North Slough
South Slough
Willamette River

FINAL PROOF SURVEY
UNDER

Application No. 33020 Permit No. 26125.....
IN NAME OF
C. E. JONES

Surveyed Sept. 28, 29, 1965, by *Clayton J. ...*