T. 2 S. R. 2 E. W.M.

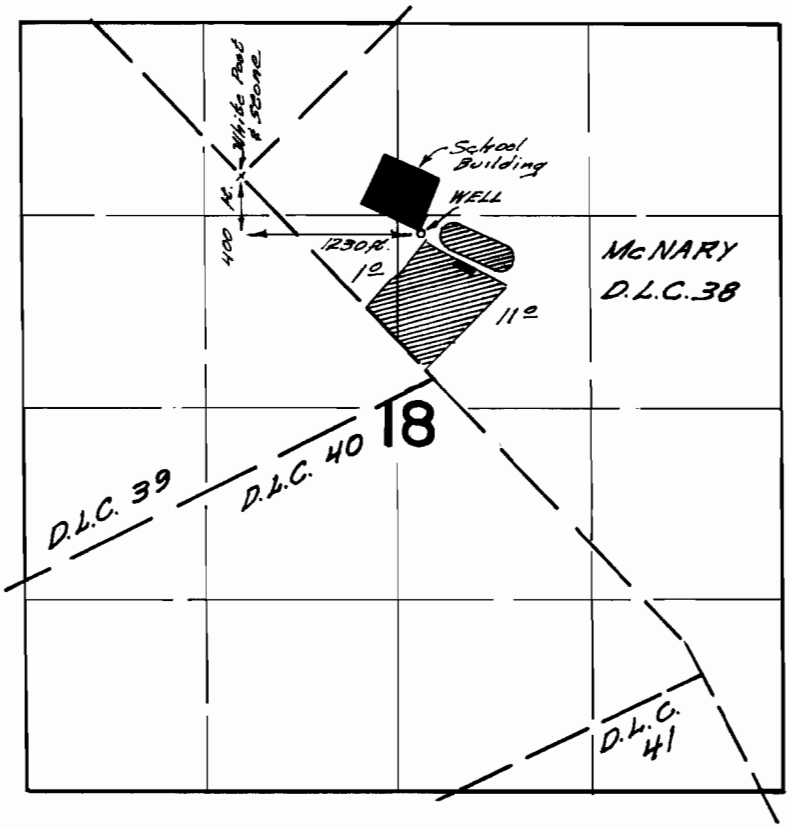

FINAL PROOF SURVEY
UNDER

Application No. G-2438 Permit No. G-2245
IN NAME OF

MILWAUKIE HIGH SCHOOL DIST. U.H. #5

Surveyed July 6 1967 by W. d. Rupert

1967-11