


T.4S.R.2E.W.M.

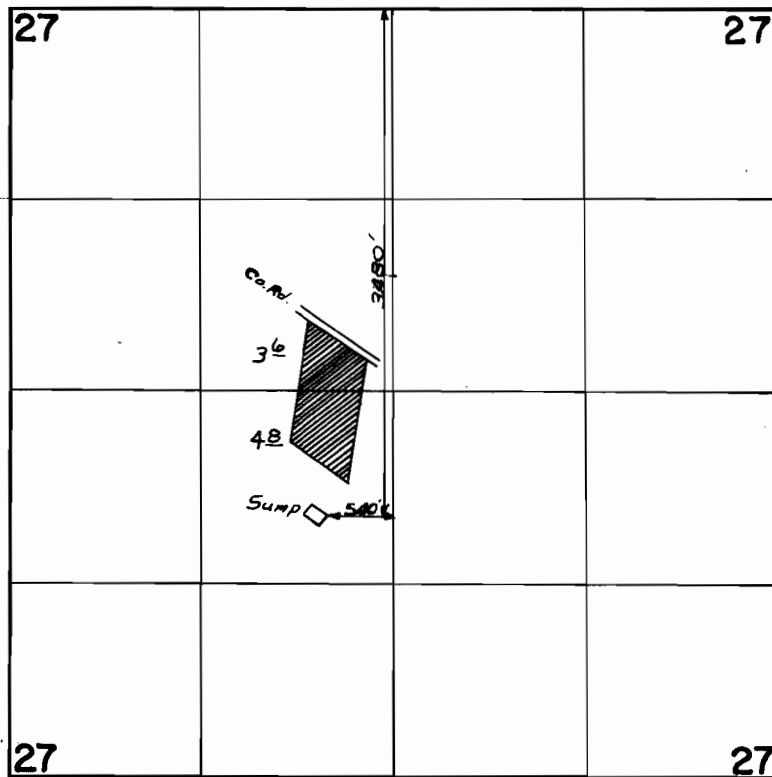

FINAL PROOF SURVEY UNDER

Application No. *G-2703* Permit No. *G-2506*
IN NAME OF

.....*James L. Howard*.....

Surveyed *Oct. 18...* 19*67*, by *W.J. Ruppert...*