


T. 4 S. R. 1 E. W. M.

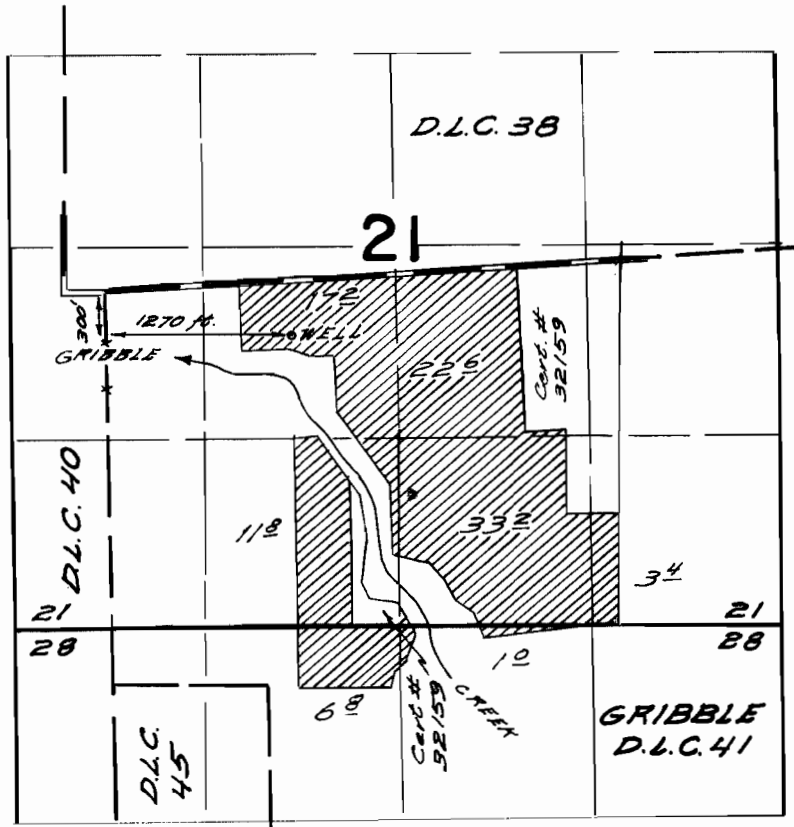

**FINAL PROOF SURVEY**  
UNDER

Application No. *G-2708* Permit No. *G-2516*  
IN NAME OF

*FRANK E. WANONA LAIS*

Surveyed *Sept. 6, 1967*, by *Wd. Ruppert*