


T. 3 S. R. 2 E. W. M.

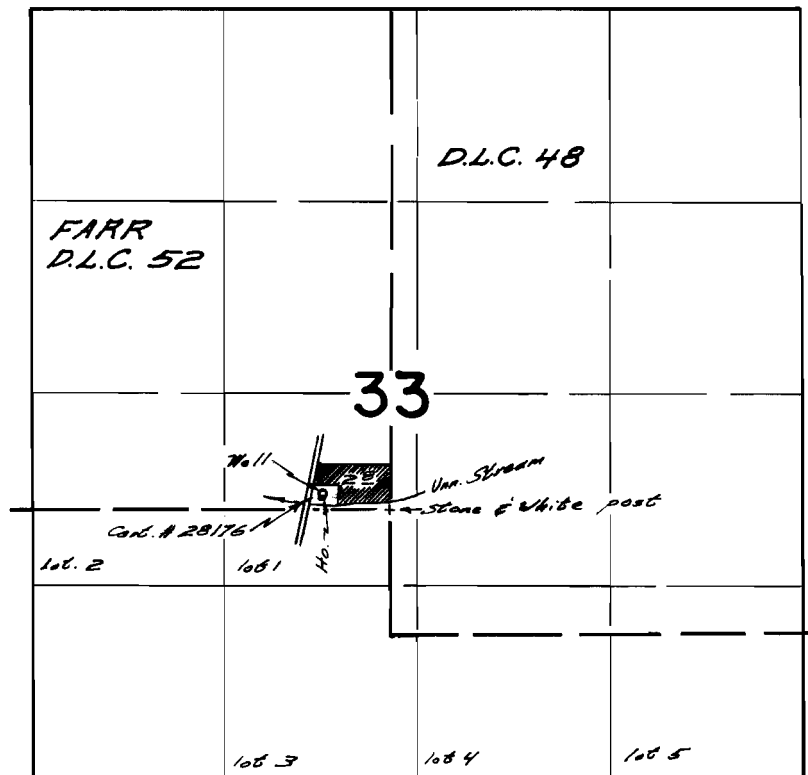

Well located 100 ft. N. & 470 ft. W. from SE. Cor. D.L.C. 52

FINAL PROOF SURVEY
UNDER

Application No. G-3566 Permit No. G-3097
IN NAME OF

MALCOLM D. HUGHES

Surveyed July 6, 1967, by W. C. Ruppert