


T.4S.R.IE.W.M.

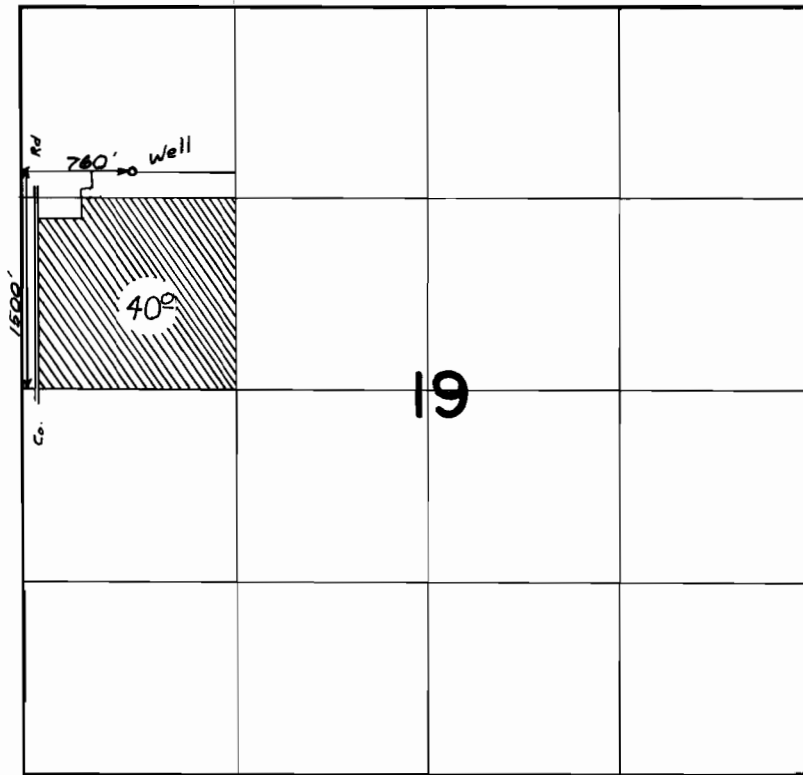

FINAL PROOF SURVEY UNDER

Application No. *G-3532* Permit No. *G-3324*
IN NAME OF

.....*Dale Matzke*.....

Surveyed *Oct. 20. 19.67.* by *W.J. Ruppert.*