


T. 3 S. R. 1 W. W. M.

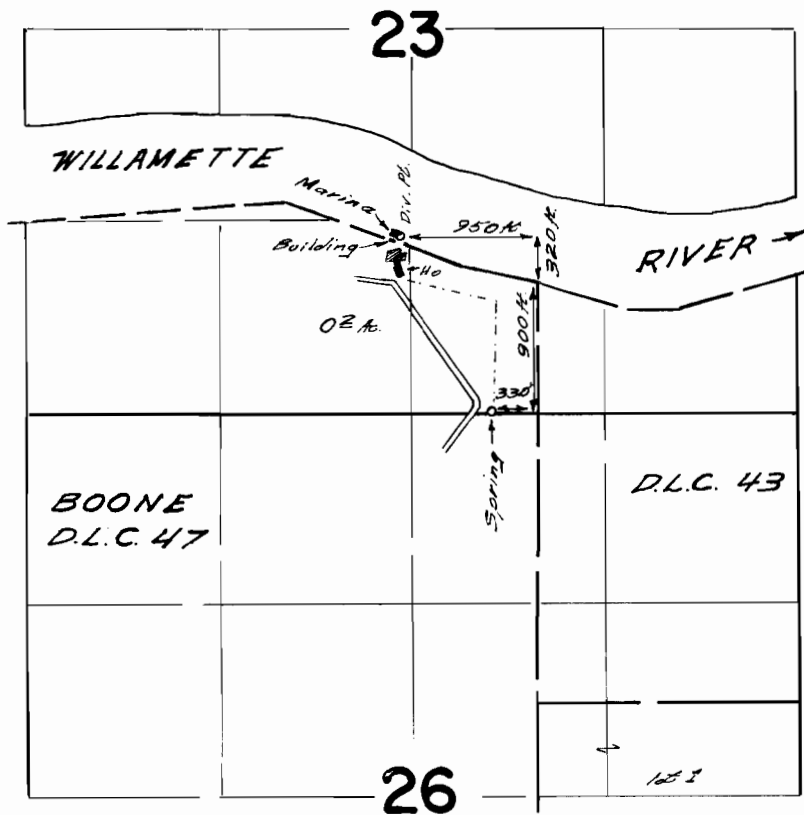

**FINAL PROOF SURVEY**  
UNDER

Application No. 38773 Permit No. 28847  
IN NAME OF

HOMER L & MARGARET J. WRIGHT

Surveyed Sept. 6, 1967, by W. d. Ruppert