


T.4S.R.1E.W.M.

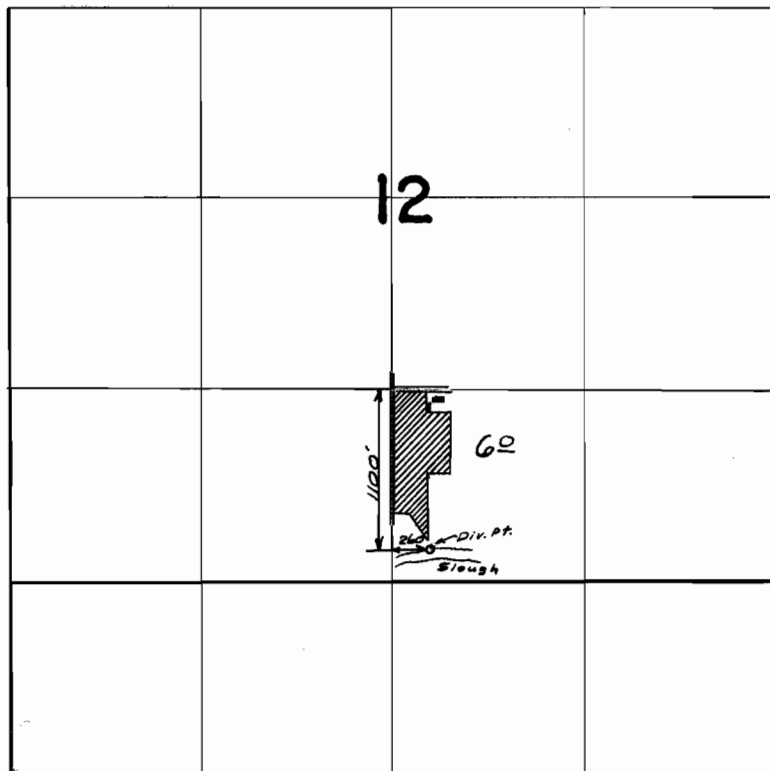

FINAL PROOF SURVEY
UNDER

Application No. 42377 Permit No. 31657
IN NAME OF

Dale W. and/or Lillian Cutsforth

Surveyed Oct. 19 1967, by W. J. Ruppert