


T.3N. R.2W. W.M.

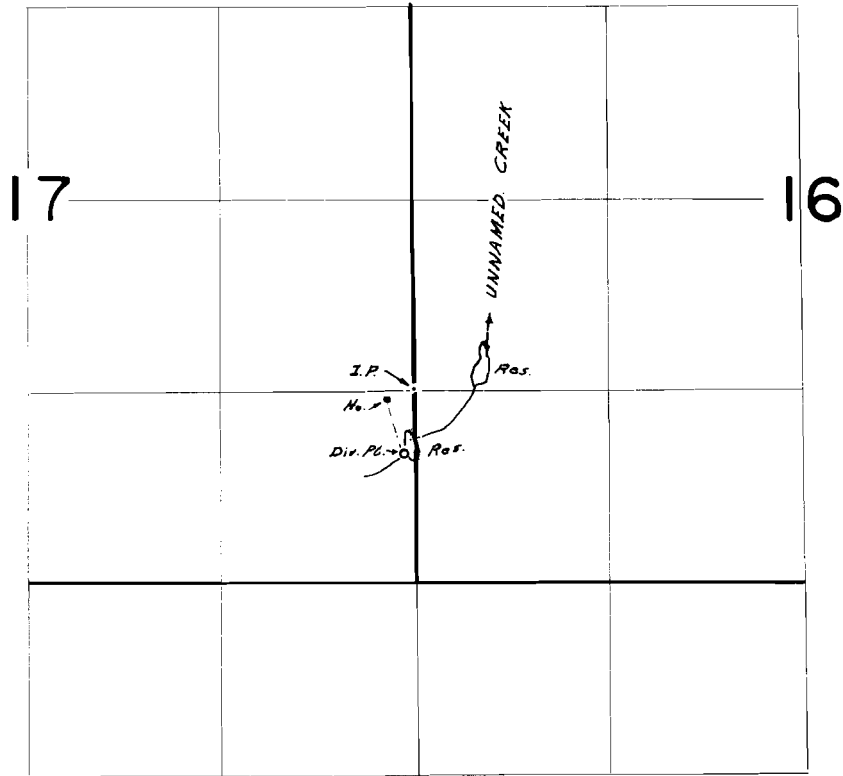

DOMESTIC DIV. PT 430 FT S. & 80 FT W. ; RES. DIV. PTS. 320 FT DUE S.
, & 320 FT. N. & 500 FT E. ; ALL FROM N.W. COR. S.W 1/4 SW 1/4 SEC. 16.

FINAL PROOF SURVEY
UNDER

Application No. 37735 R-37770 Permit No. 28129 R-2996
IN NAME OF

C. J. STEYAERT & FRED W. BARTEL

Surveyed Sept 29 1966, by W. D. Ruppert