


T.3N. R.2W. W.M.

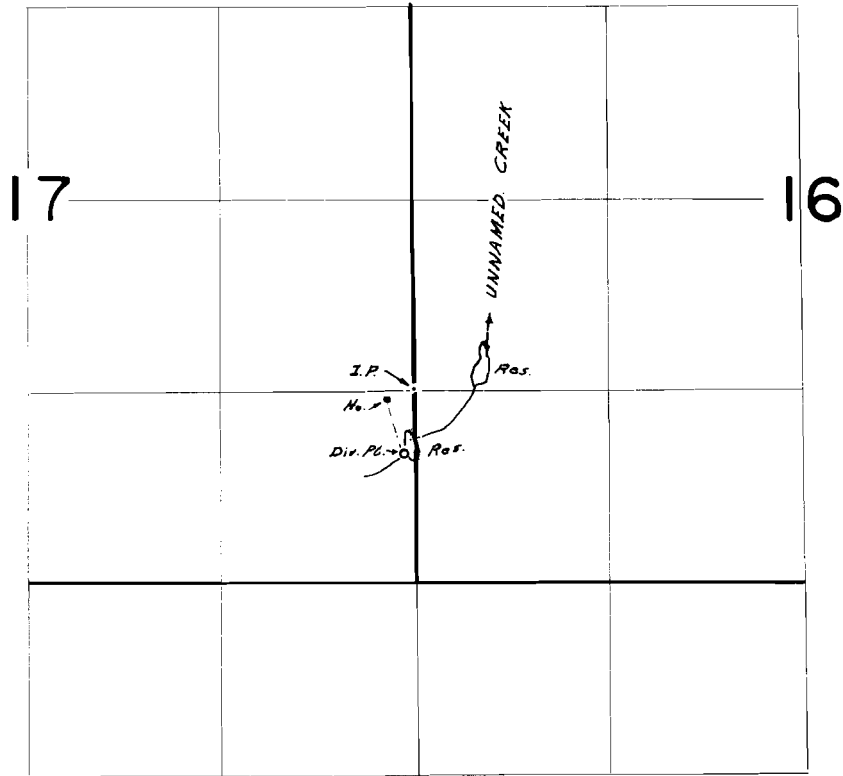

DOMESTIC DIV. PT 430 FT S. & 80 FT W. ; RES. DIV. PTS. 320 FT DUE S.  
, & 320 FT. N. & 500 FT E. ; ALL FROM N.W. COR. S.W 1/4 SW 1/4 SEC. 16.

**FINAL PROOF SURVEY**  
UNDER

Application No. <sup>37735</sup> ~~R-37770~~ Permit No. <sup>28129</sup> ~~R-2996~~  
IN NAME OF

*C. J. STEYAERT & FRED W. BARTEL*

Surveyed *Sept 29 1966*, by *W. D. Ruppert*