


T.27S. R.4W. W.M.

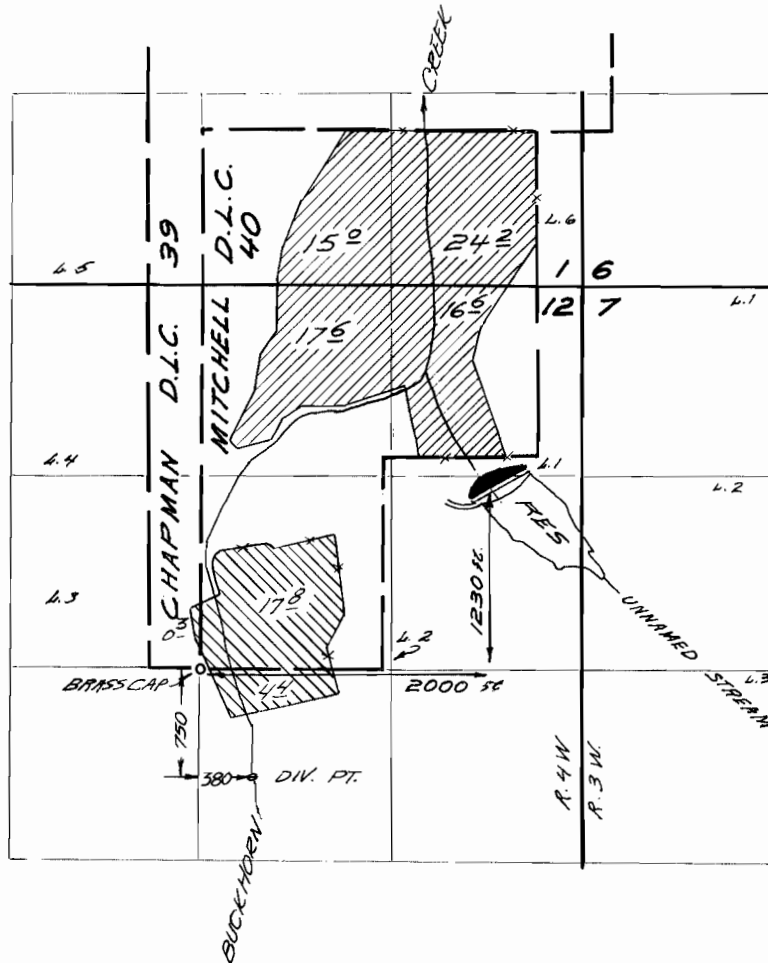


FINAL PROOF SURVEY UNDER

R-31319 R-2047
Application No. 31320 Permit No. 25017
IN NAME OF

Estle L. Paris

Surveyed April 19, 1967, by *W. J. Ruppert*

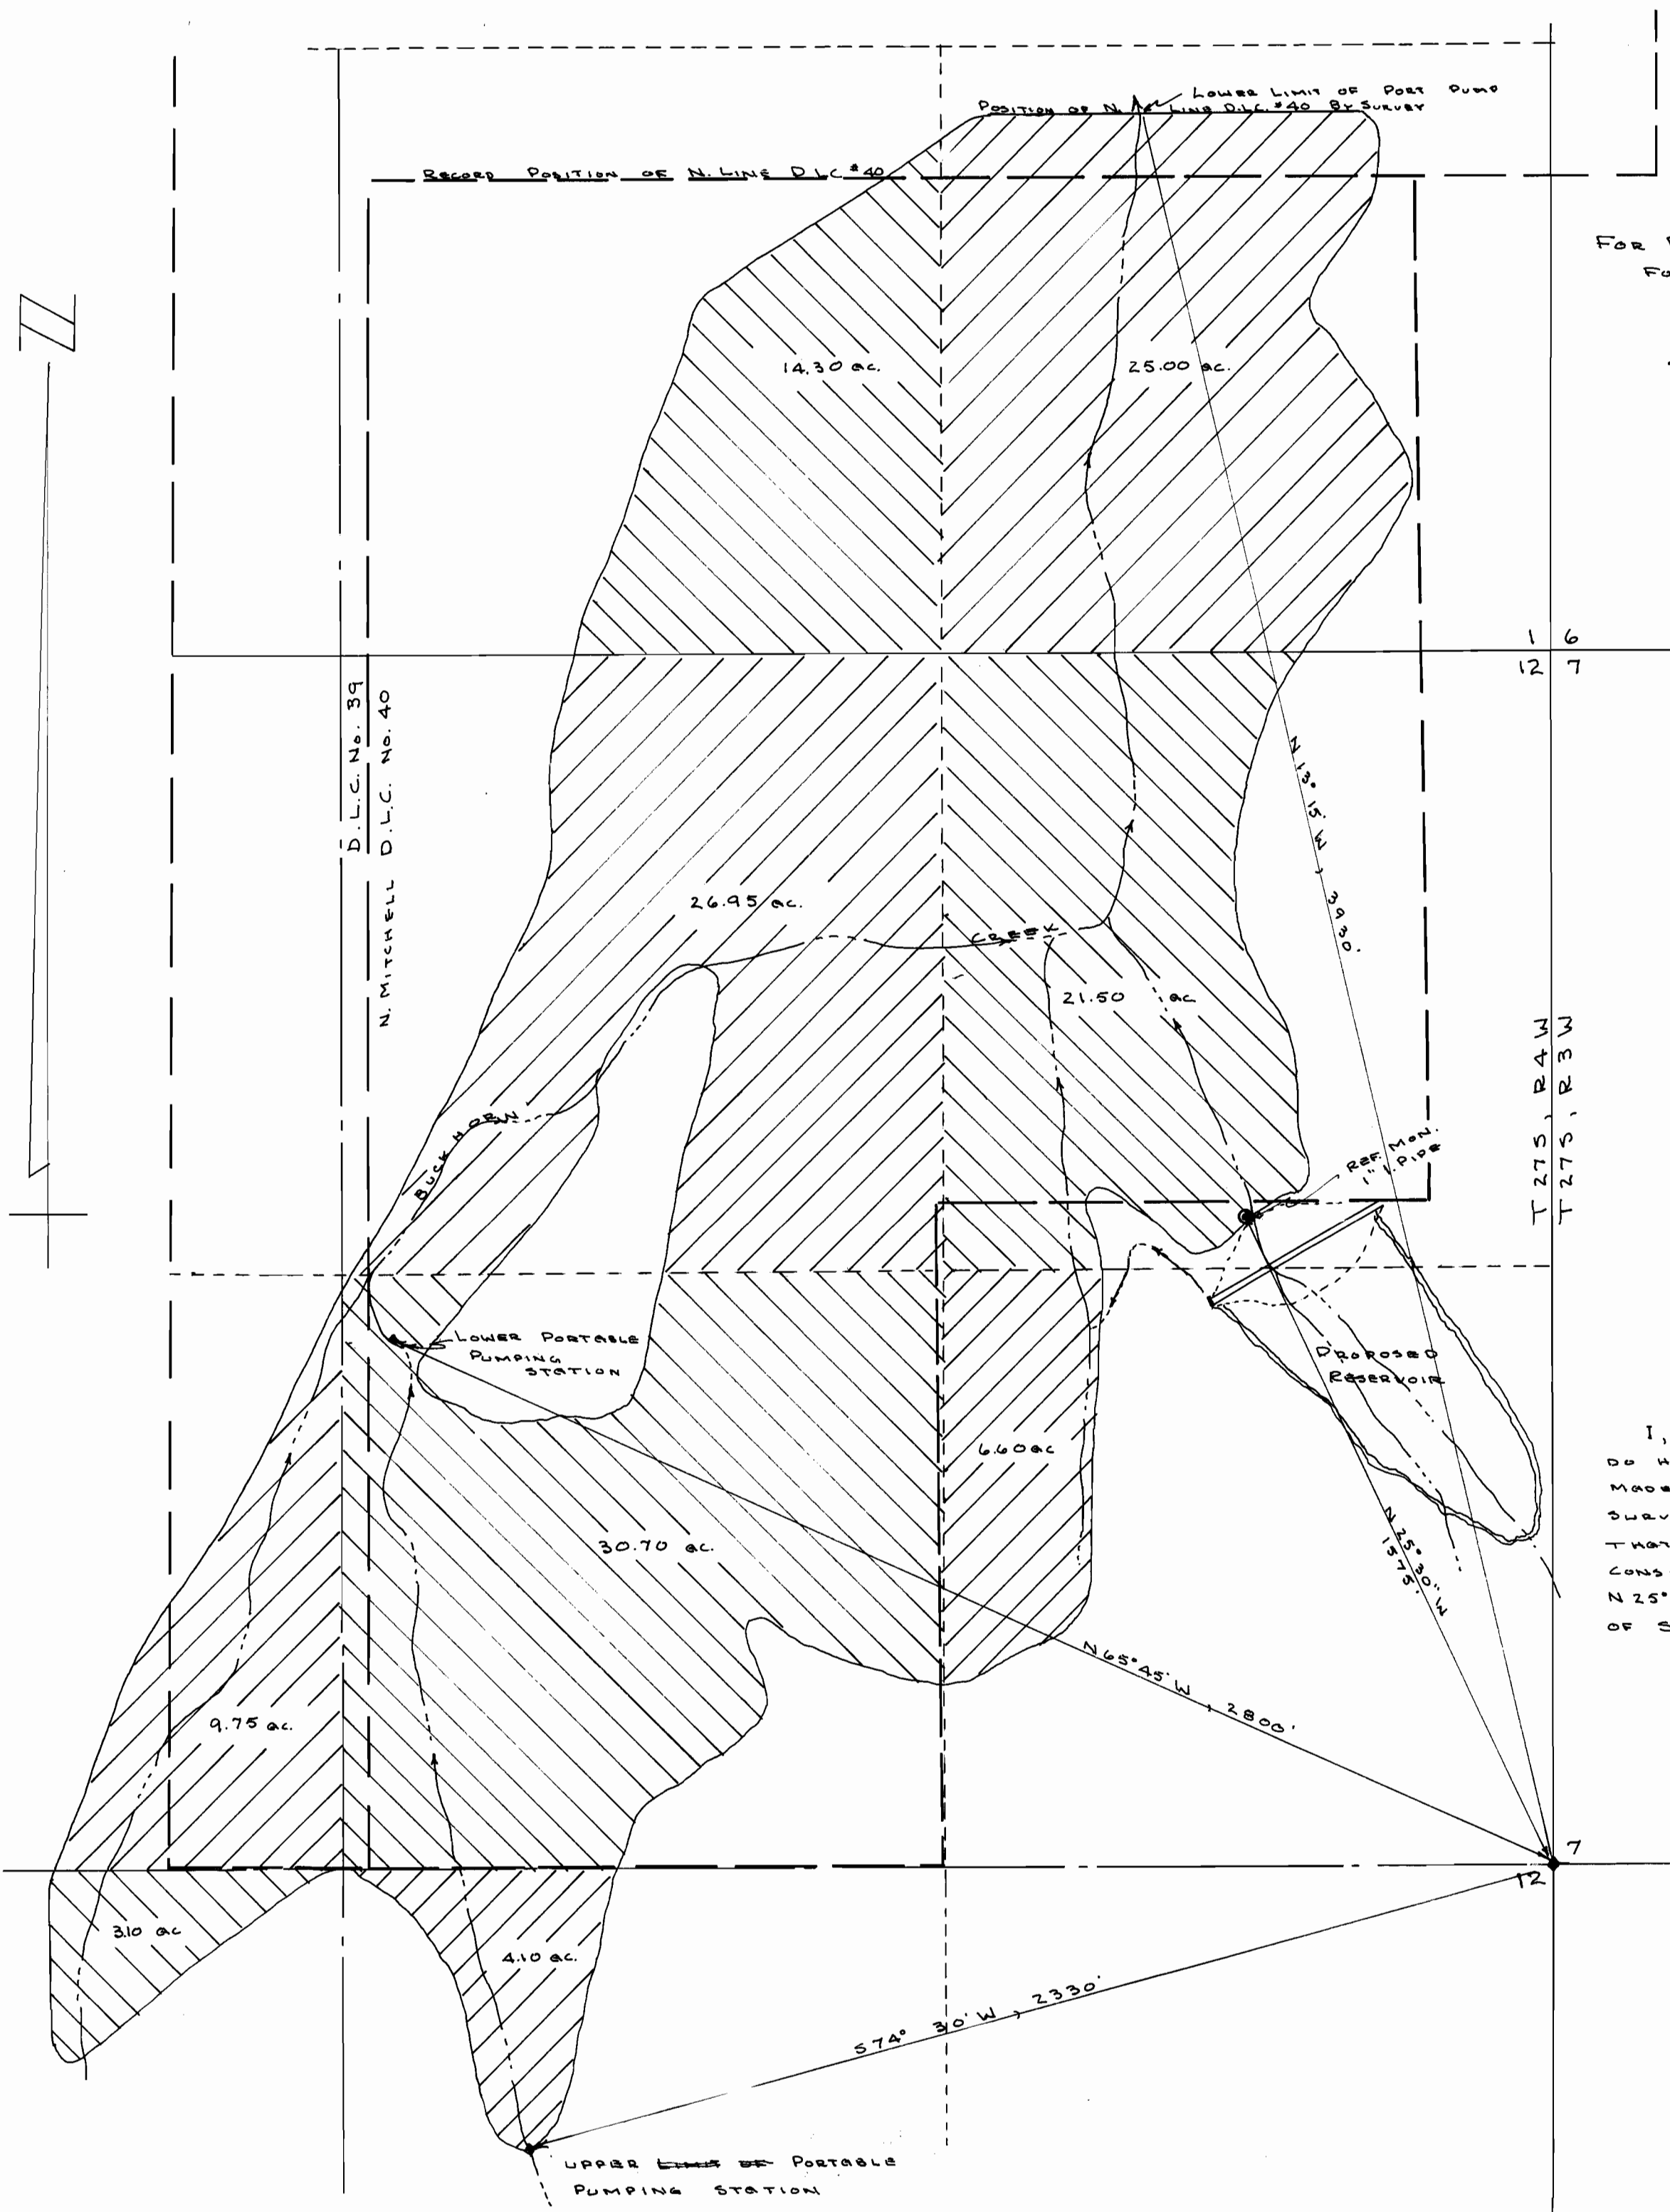


MAP
FOR PERMITS TO STORE AND APPROPRIATE
FOR BENEFICIAL USE THE PUBLIC WATERS
OF THE STATE OF OREGON

IN
SECS. 1 & 12, T.27S.; R.W.; W. M.
DOUGLAS COUNTY, OREGON

APPLICANT:
E. L. PARIS - RT. 2, Box 540
ROSBURG, OREGON

PREPARED BY:
GENE E. JOHNSON
ROSBURG, OREGON

SCALE: 1" = 300'

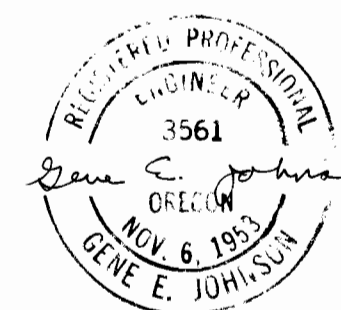

I, GENE E. JOHNSON, OF ROSBURG, OREGON,
DO HEREBY CERTIFY THAT THIS MAP WAS
MADE FROM NOTES TAKEN DURING AN ACTUAL
SURVEY MADE BY ME IN DECEMBER 1956;
THAT THE MONUMENT SHOWN ON THIS MAP
CONSISTING OF A 1" X 36" GALV. IRON PIPE IS
N 25° 30' W, 1573' FROM THE EAST 1/4 CORNER
OF SECTION 12, T.27S.; R.W.; W.M.

Gene E. Johnson

Application No. R-31319 & 31320
Permit No. R-2047 & 25017