


T. 26 S. R. 6 W. W. M.

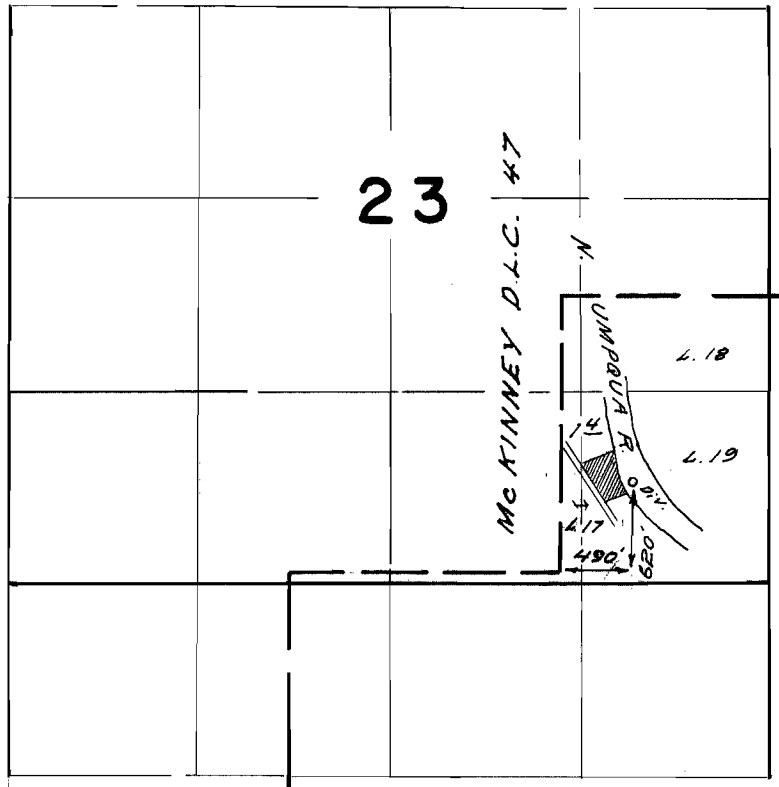

**FINAL PROOF SURVEY**  
UNDER

Application No. 38247 Permit No. 28504  
IN NAME OF

William H. Anderson

Surveyed July 13, 1967, by W. D. Ruppert