


T. 29 S. R. 6 W. W. M.

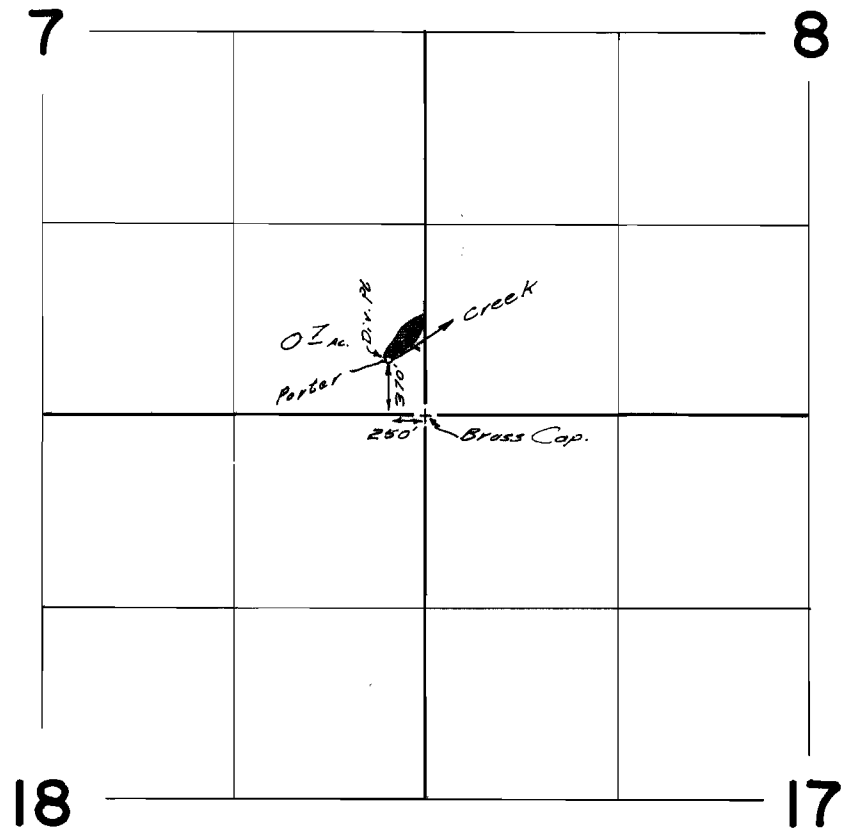

FINAL PROOF SURVEY
UNDER

Application No. 39100 Permit No. 29107
IN NAME OF

Richard C. Smallwood

Surveyed Sept. 29, 1967, by W. d. Ruppert