

# OAK GROVE PARK

SECTIONS 20, 21, T27 S., R4W., W.M.

DOUGLAS COUNTY, OREGON

BEN. B. IRVING REG. CIVIL ENGINEER.

ROSEBURG, OREGON.

SCALE 1"=100'

Note:-  
The 5' Strips of land shown, lying alongside of Lot lines, are for Easements for Water Pipe Lines to the Lots lying at the Northernly end of said strips, from Deer Creek.


STATE OF OREGON )  
COUNTY OF DOUGLAS ) ss

I, Ben. B. Irving, being duly sworn, depose and say upon oath: That I am the Surveyor who made the survey and prepared the final map of "OAK GROVE PARK" and that the foregoing tracing is an exact copy of the map of said "OAK GROVE PARK".

*Ben. B. Irving*  
Civil Engineer

Subscribed and sworn to before me this 18<sup>th</sup> day of March 1948.

*Roy Agee*  
County Clerk.

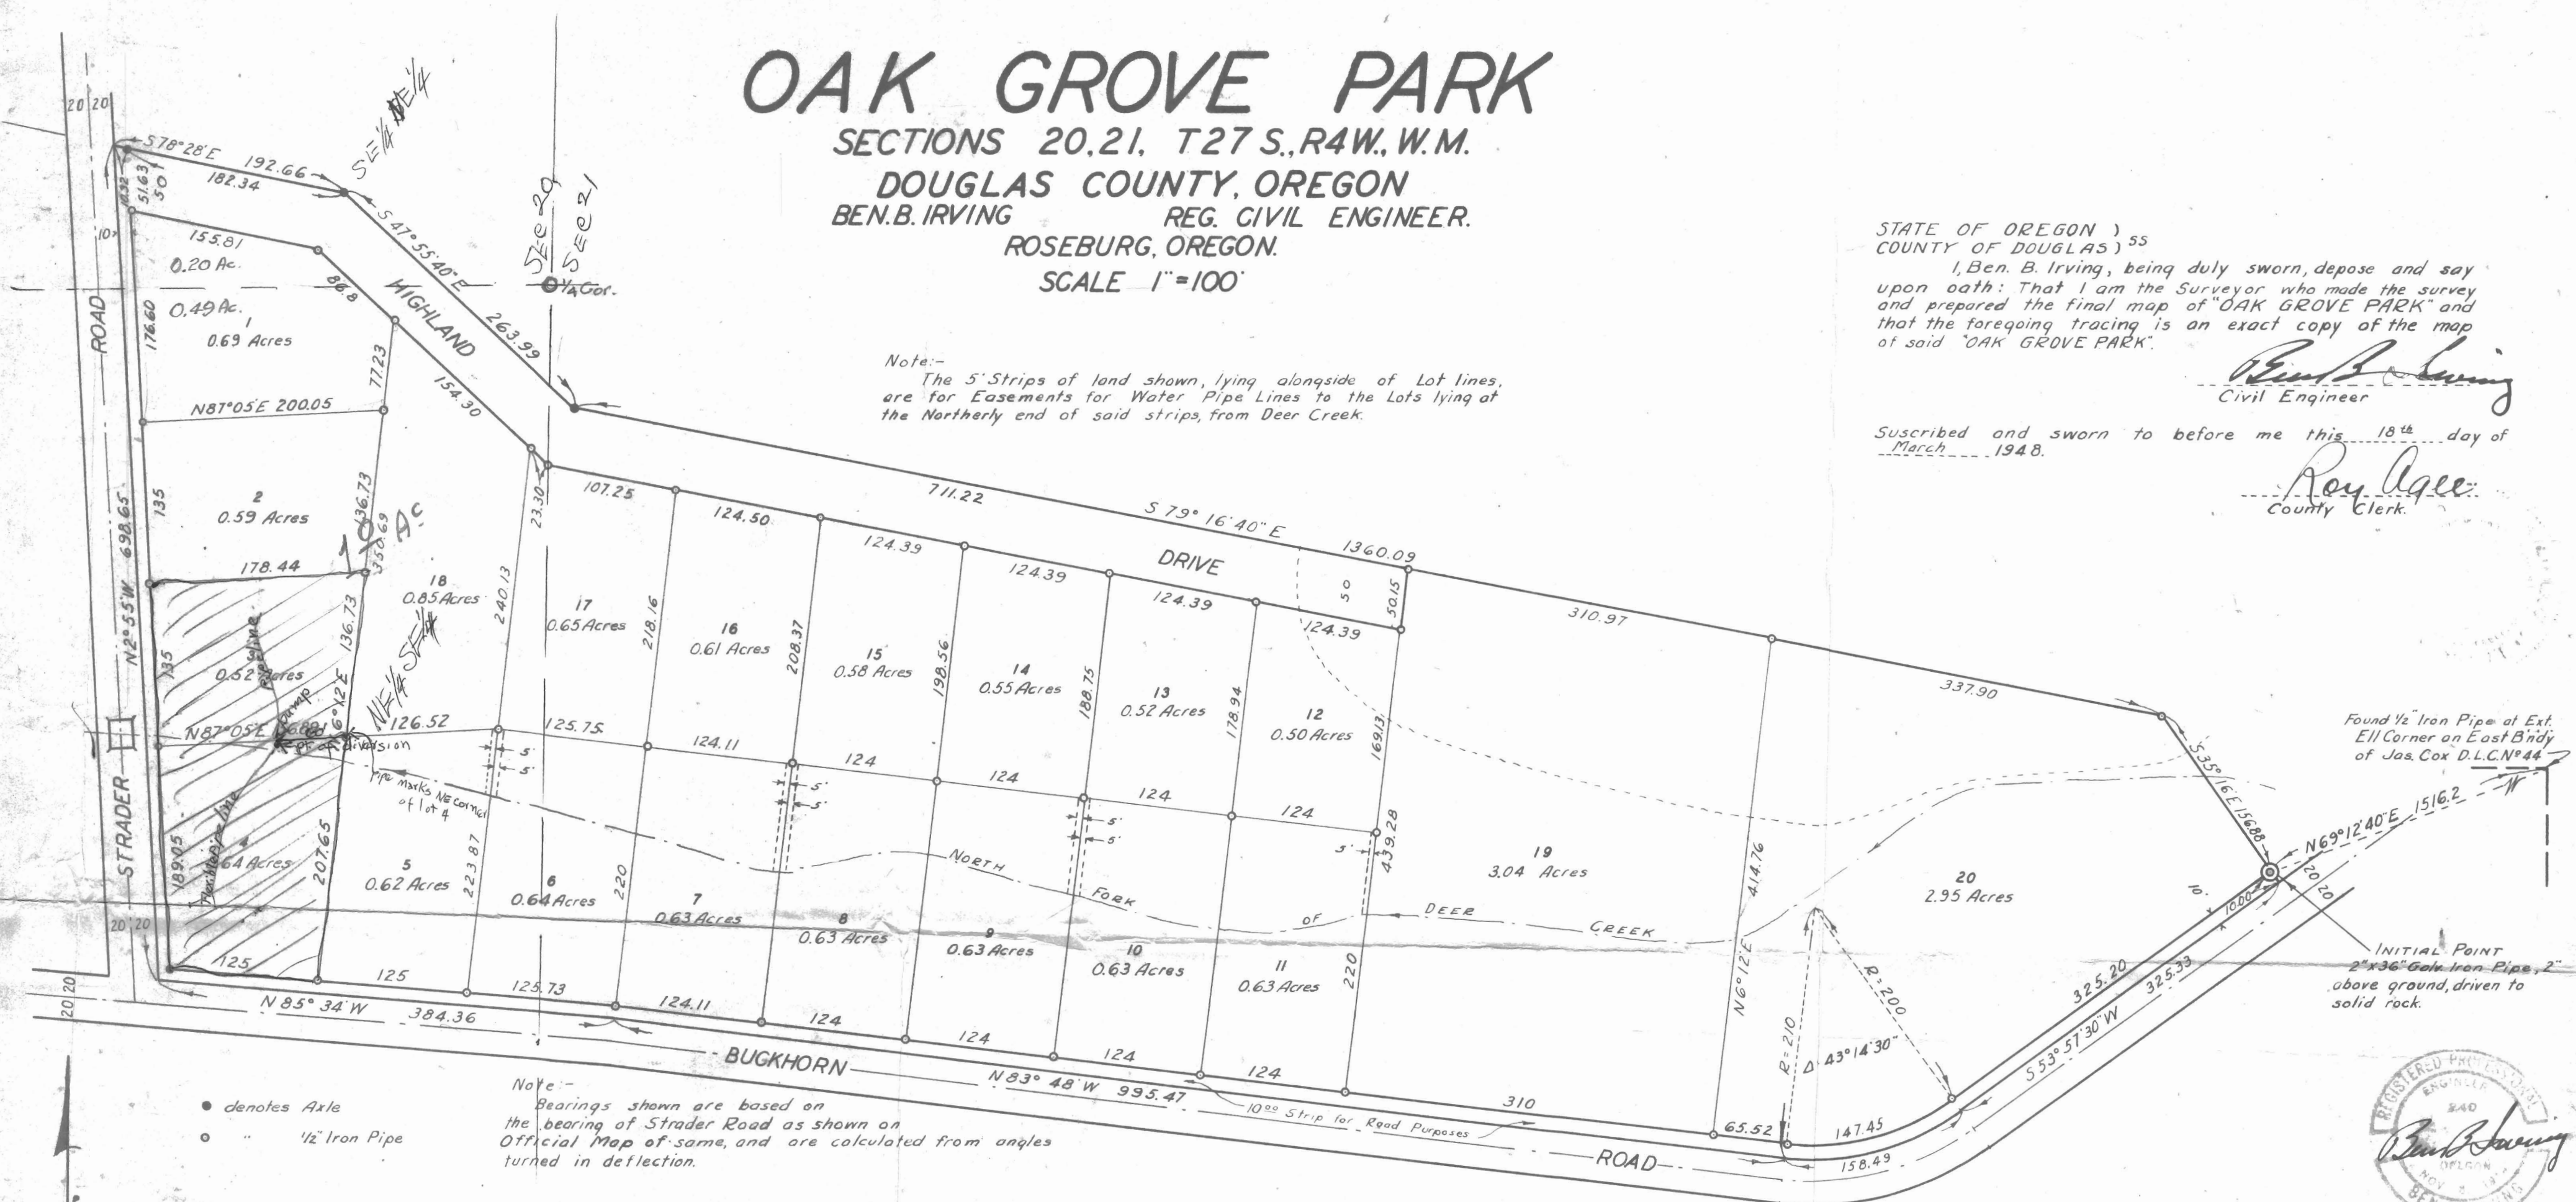

Note:-  
Bearings shown are based on the bearing of Strader Road as shown on Official Map of same, and are calculated from angles turned in deflection.

- denotes Axle
- " 1/2" Iron Pipe

### DEDICATION

KNOW ALL MEN BY THESE PRESENTS that WE, G.A. Lindbloom and Hattie C. Lindbloom, Husband and Wife, owners of the lands represented and described on the annexed plat, have caused the same to be surveyed and platted by the name of "OAK GROVE PARK" and we hereby dedicate to the use of the public forever, the road shown thereon.

IN TESTIMONY WHEREOF, the said G.A. Lindbloom and Hattie C. Lindbloom have hereunto set their hands, this 18<sup>th</sup> day of March 1948.

*G.A. Lindbloom*  
G.A. Lindbloom.  
*Hattie C. Lindbloom*  
Hattie C. Lindbloom.

### ACKNOWLEDGEMENT

STATE OF OREGON ) ss  
COUNTY OF DOUGLAS )  
On the 18<sup>th</sup> day of March 1948, before me appeared G.A. Lindbloom and Hattie C. Lindbloom, to me personally known, who being duly sworn, did say that they are the lawful owners of the tract of land delineated on the annexed plat, and that they do hereby acknowledge that they signed the accompanying dedication as their free and voluntary act and deed.

IN TESTIMONY WHEREOF, I have hereunto set my hand and affixed my official seal this day and year above written.

*Roy Agee*  
COUNTY CLERK.

### CERTIFICATE OF SURVEYOR.

STATE OF OREGON ) ss  
COUNTY OF DOUGLAS )

I, Ben. B. Irving, being first duly sworn, depose and say that I have correctly surveyed and marked with proper monuments the lands delineated on the annexed plat, of which the following is a true and correct description: - Beginning at a 2" x 36" Galv. Iron Pipe, 2" above ground, and driven to solid rock, from which pipe the Exterior E.I. Corner on the East boundary of the Jas. Cox D.L.C. No. 44, T27S., R4W., W.M. bears N69°12'40"E 1516.2'; Thence S35°16'E 10.00' to a point on the North boundary of Buckhorn Road; Thence following said boundary S53°57'30"W 325.32 ft. to the beginning of a curve to the right, having a radius of 210.00 ft. and a central angle of 43°14'30"; 

Oregon No. 240.  
November 8, 1919.

*Ben. B. Irving*  
Ben. B. Irving  
Registered Professional Engineer

Subscribed and sworn to before me this 18<sup>th</sup> day of March 1948.

*Roy Agee*  
COUNTY CLERK.

APPROVED March 19 1948.

*D.N. Busenbark*  
COUNTY JUDGE.

APPROVED 19 March 1948.

*Ned Dixon*  
COUNTY ASSESSOR.

APPROVED March 18 1948.

*Ben. B. Irving*  
COUNTY SURVEYOR.

FILED March 19<sup>th</sup> 1948  
*Roy Agee*  
COUNTY CLERK.

Application No. 40148  
Permit No. 29927

RECEIVED AUG 6 1964  
STATE ENGINEER SALEM, OREGON  
RECEIVED JUL 31 1962  
STATE ENGINEER SALEM, OREGON