


T.27S. R.283W. W.M.

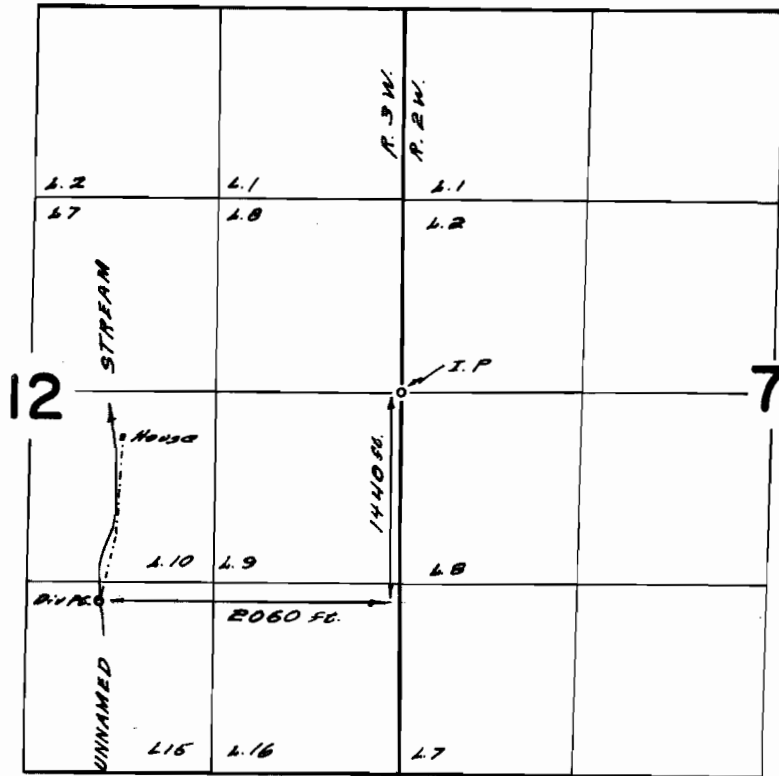

FINAL PROOF SURVEY
UNDER

Application No. 40361 Permit No. 30092
IN NAME OF

Edgar Wiggins

Surveyed June 9, 1967, by W. H. Ruppert