


T. 27 S. R. 6 W. W.M.

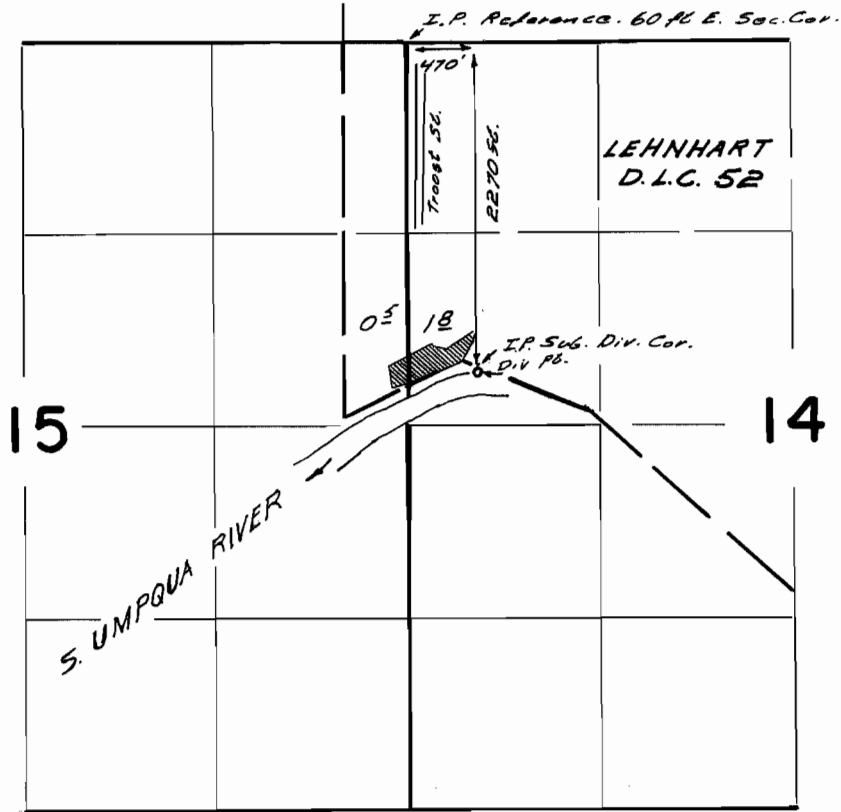

FINAL PROOF SURVEY
UNDER

Application No. 40472 Permit No. 30160
IN NAME OF

Robert Bailey

Surveyed May 12 1967, by W. J. Ruppert
July 17 67