


T. 28 S. R. 5 W. W. M.

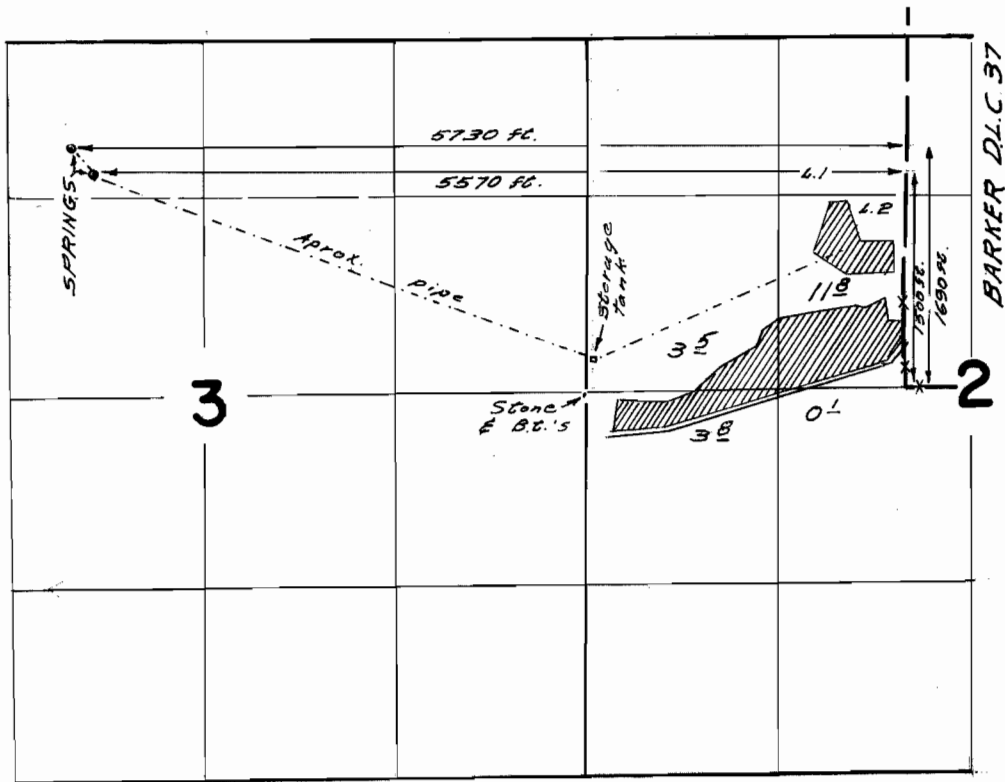

**FINAL PROOF SURVEY**  
UNDER

Application No. 41061 Permit No. 30596  
IN NAME OF

Lucius L. & Bertha R. Patterson

Surveyed May 11, 1967, by W. J. Ruppert.