


T.26S. R.4W. W.M.

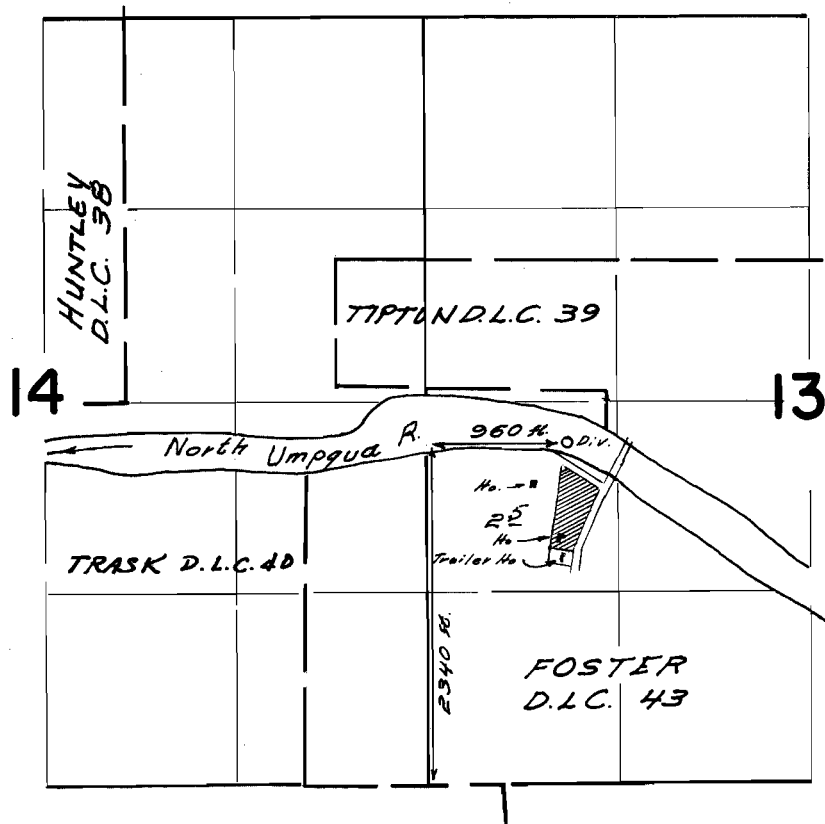

FINAL PROOF SURVEY UNDER

Application No. 41757 Permit No. 30741
IN NAME OF

Walter M. & Ora M. Thomas

Surveyed April 18 1967, by Wd. Ruppert