


T. 26 S. R. 3 W. W.M.

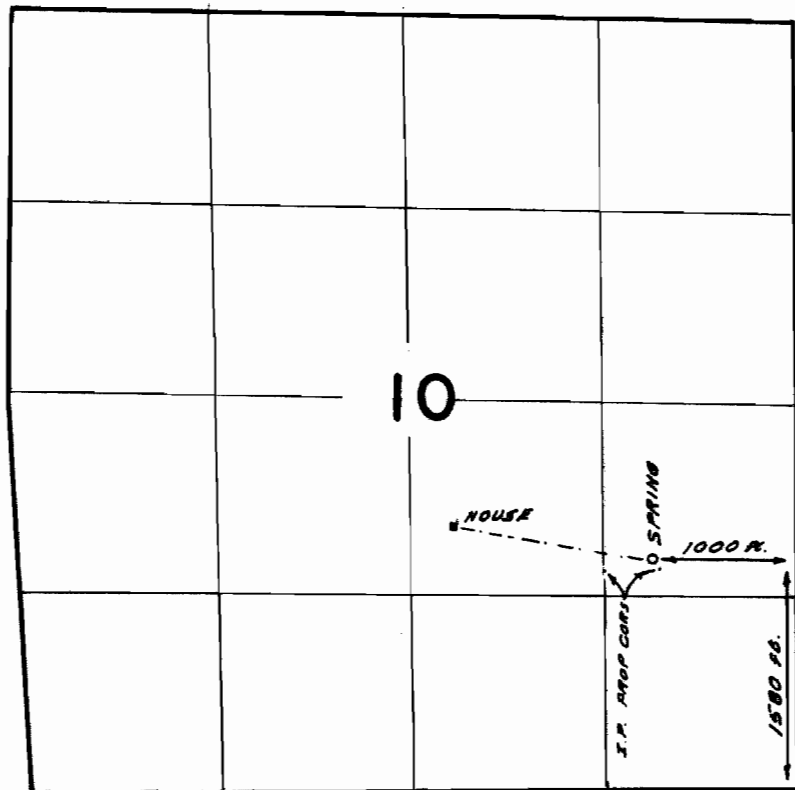

**FINAL PROOF SURVEY**  
UNDER

Application No. 41248 Permit No. 30759  
IN NAME OF

A. B. SMITH

Surveyed April 25, 1967, by N. J. Ruppert