


T. 30 S. R. 5 W. W.M.

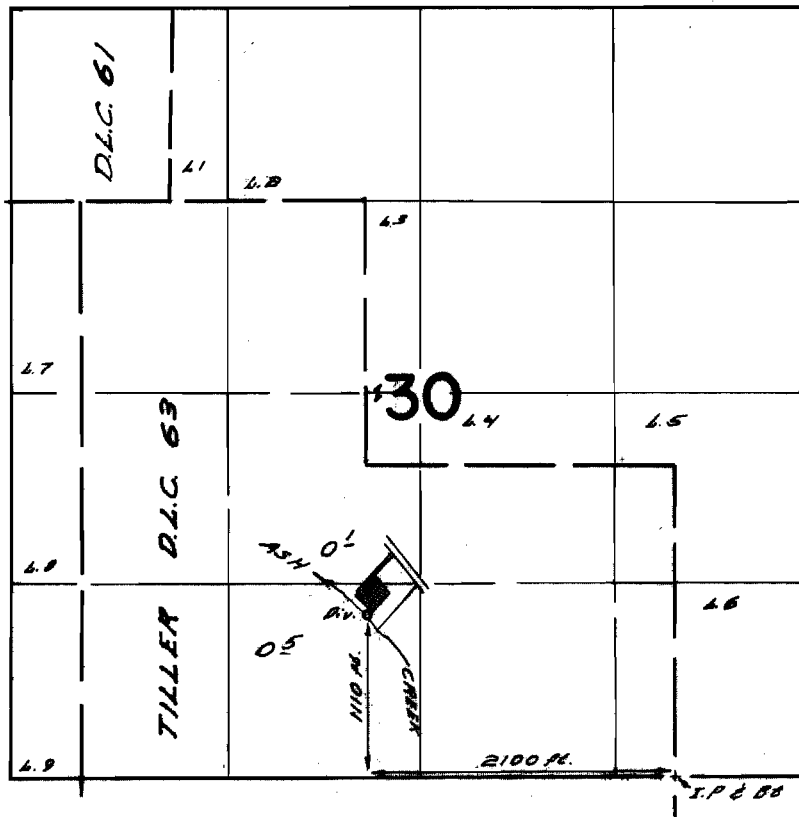

FINAL PROOF SURVEY UNDER

Application No. 41350 Permit No. 30874
IN NAME OF

Odell J. Spain

Surveyed Sept. 26 1967, by W. J. Ruppert