


T. 26 S. R. 2 W. W.M.

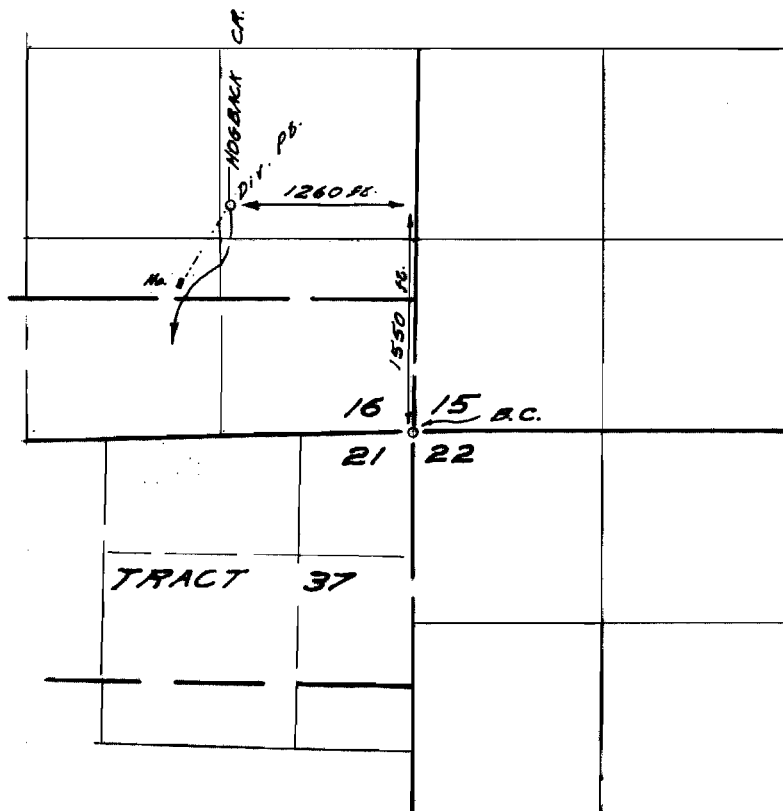

FINAL PROOF SURVEY
UNDER

Application No. 41461 Permit No. 30856
IN NAME OF

Max W. Lockwood

Surveyed May 11 1967, by W. d. Rupperts