


T. 27 S. R. 2 W. W.M.

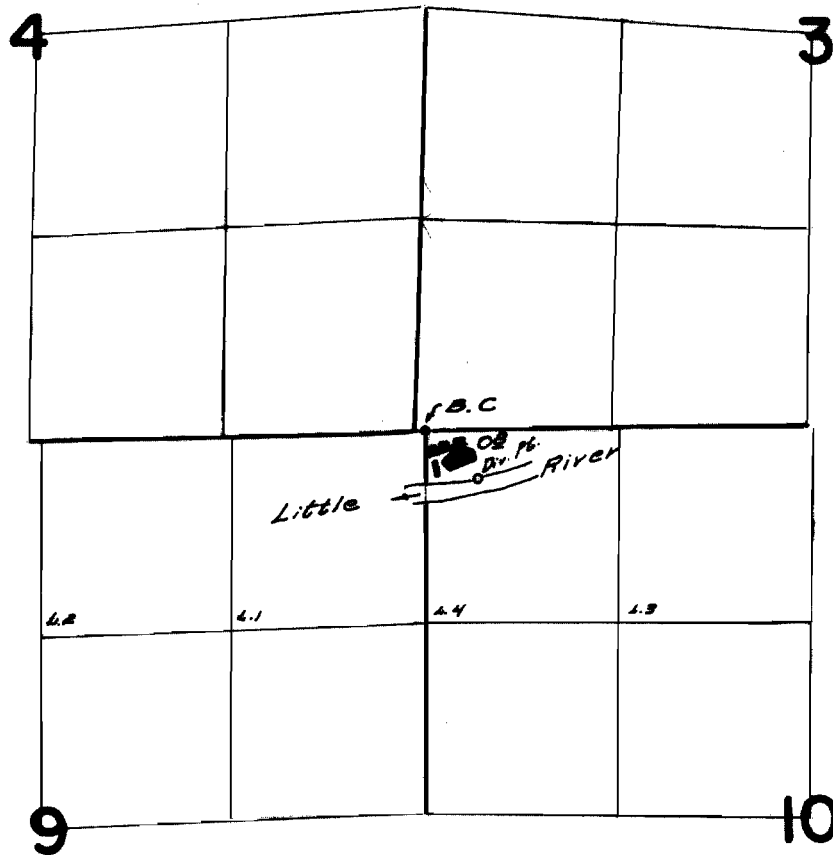

DIVERSION POINT LOCATED 330 N. S. & 360 P. E.  
FROM N.E. CORNER OF SECTION 10

**FINAL PROOF SURVEY**  
UNDER

Application No. 41522 Permit No. 30982  
IN NAME OF

Southern Oregon Association of  
Christian Churches  
Surveyed April 18, 1962, by W. J. Ruppberg