


T. 26S. R. 3W. W.M.

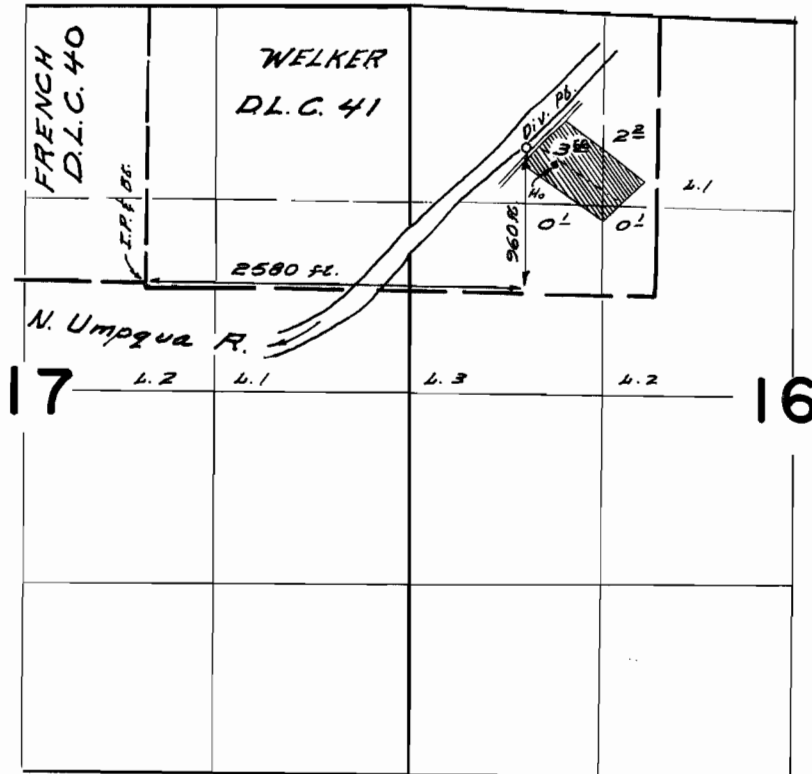

FINAL PROOF SURVEY
UNDER

Application No. 42226 Permit No. 31219
IN NAME OF

Elmer W. & Virginia Hurd

Surveyed May 10, 1967, by W. J. Ruppert