


T. 26 S. R. 3 W. W. M.

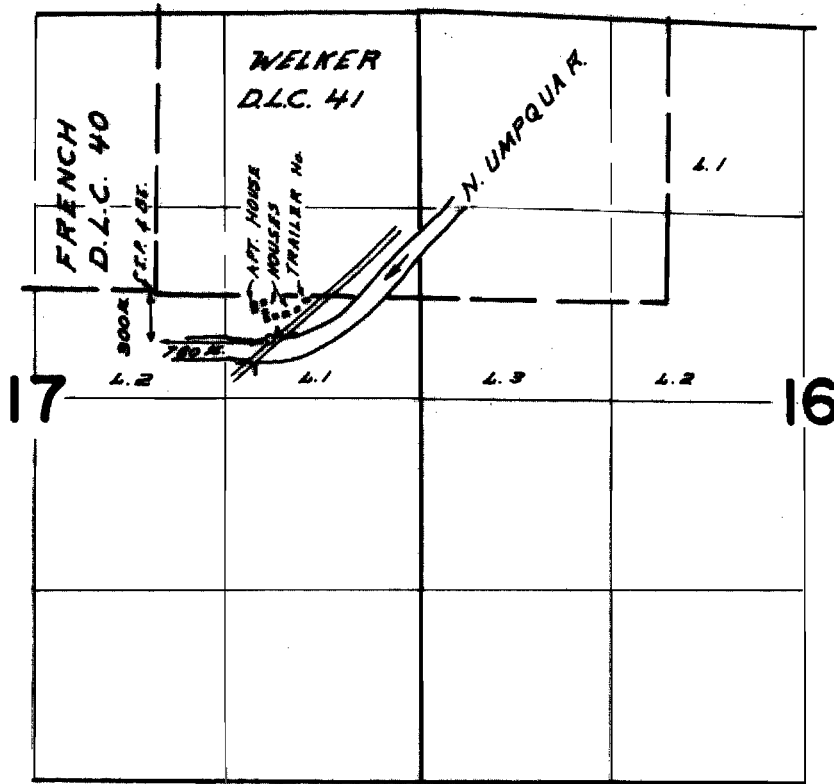

FINAL PROOF SURVEY
UNDER

Application No. 42004 Permit No. 31435
IN NAME OF

L. E. & Margaret Medlar

Surveyed April 25 1967, by W. D. Ruppert