
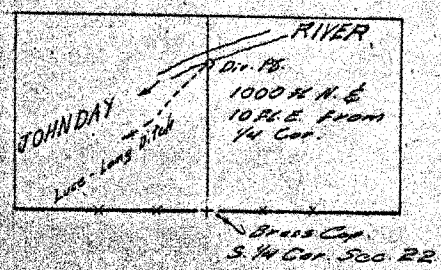


P-27553
35330

T.13 S. R. 31 E. W.M

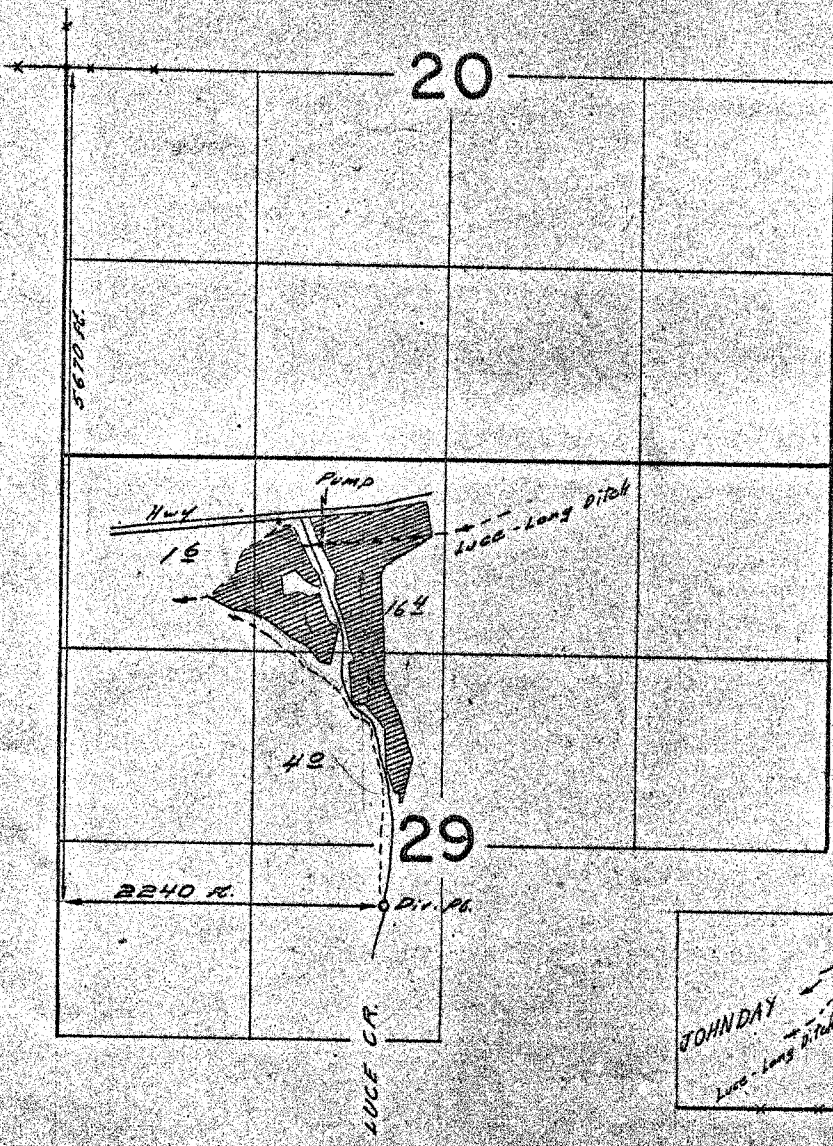

FINAL PROOF SURVEY UNDER

Application No. 36120. Permit No. 27553
IN NAME OF

Homer W. Barry

Surveyed June 6, 1966, by *W.J. Ruppert*
June 30 67