


T.15S. R.30E. W.M.

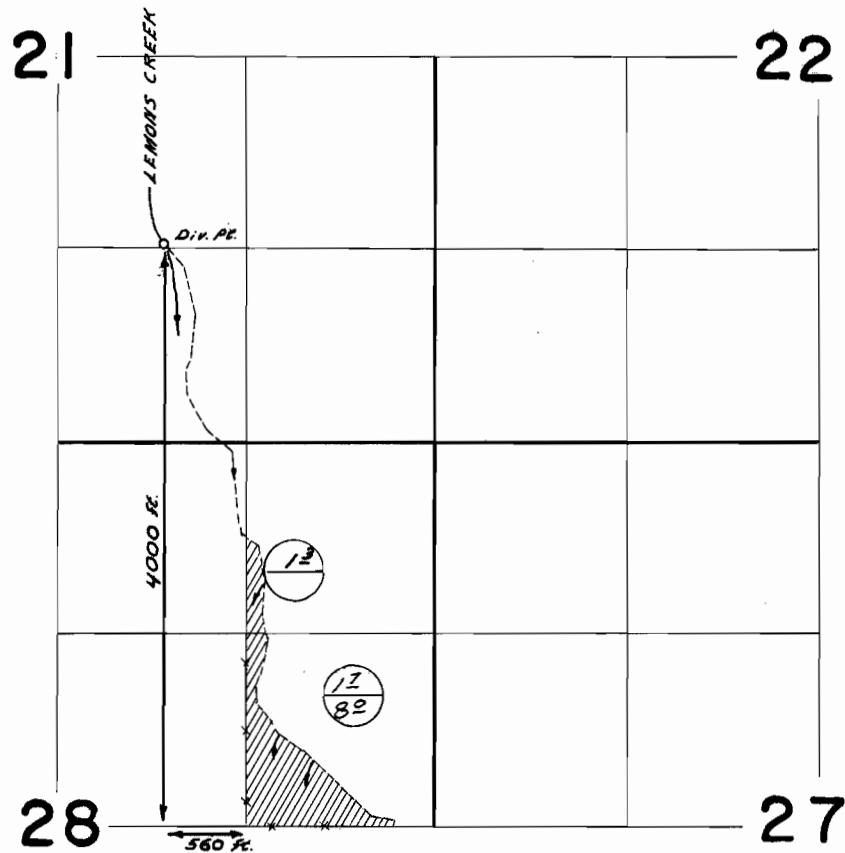

FINAL PROOF SURVEY
UNDER

Application No. 37007 Permit No. 27784
IN NAME OF

FARREL LEMONS

Surveyed June 3, 1966, by W.J. Ruppert