



T.33S. R.2E. W.M.

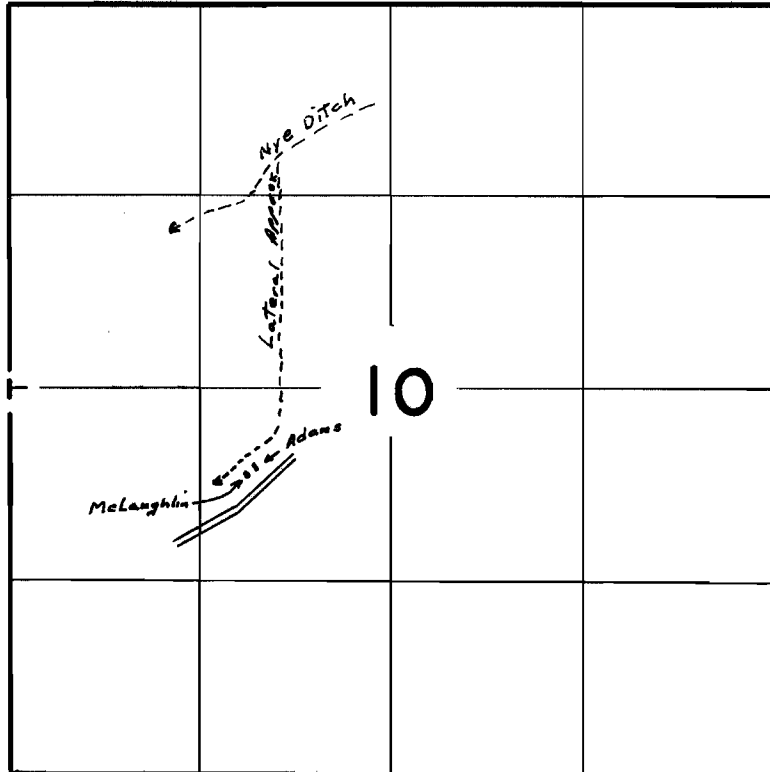

T.32S. R.3E. W.M.

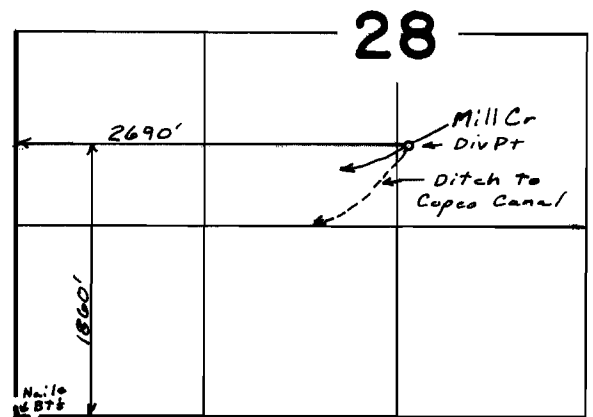

FINAL PROOF SURVEY
UNDER

Application No. 37317 Permit No. 27799
IN NAME OF

Vela L. Adams & Nellie M. McLaughlin

Surveyed May 22 1967, by W. J. Ruppert