



T.33S.R.2E.W.M.

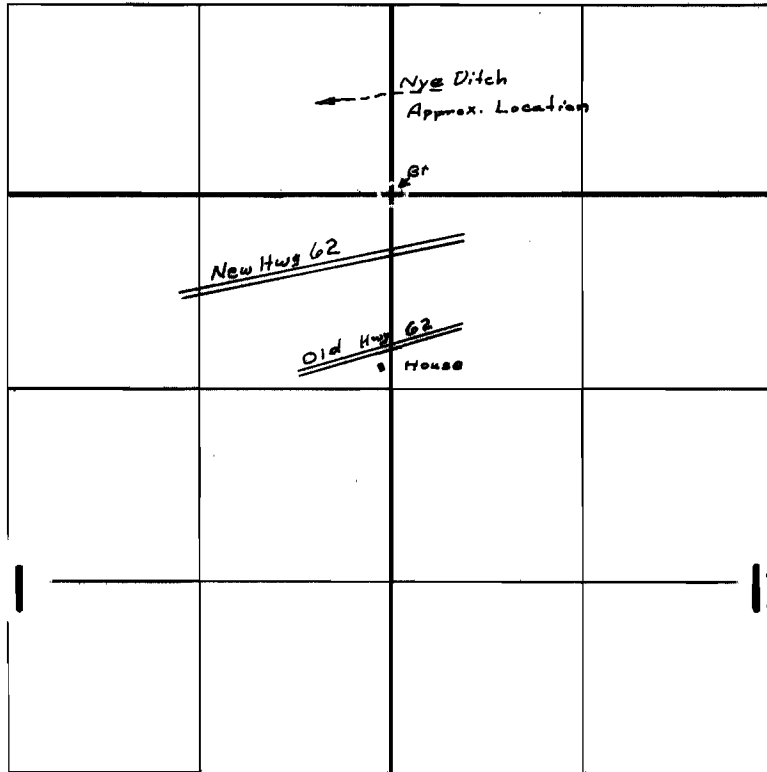

T.32S.R.3E.W.M.

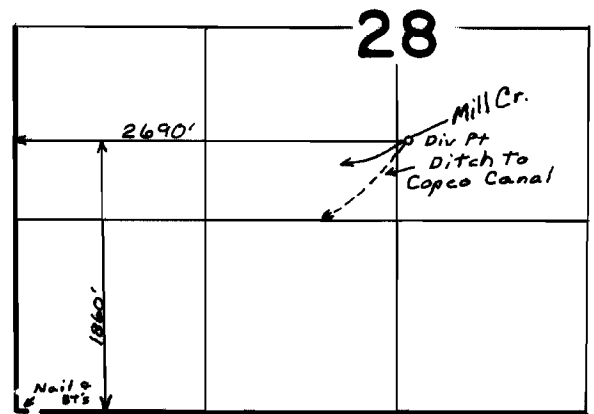

FINAL PROOF SURVEY
UNDER

Application No. 38516 Permit No. 28669
IN NAME OF

Mabel L. Hedgpeth

Surveyed May 22, 1967, by W. V. Ruppert