


# T.33S.R.1E.W.M.

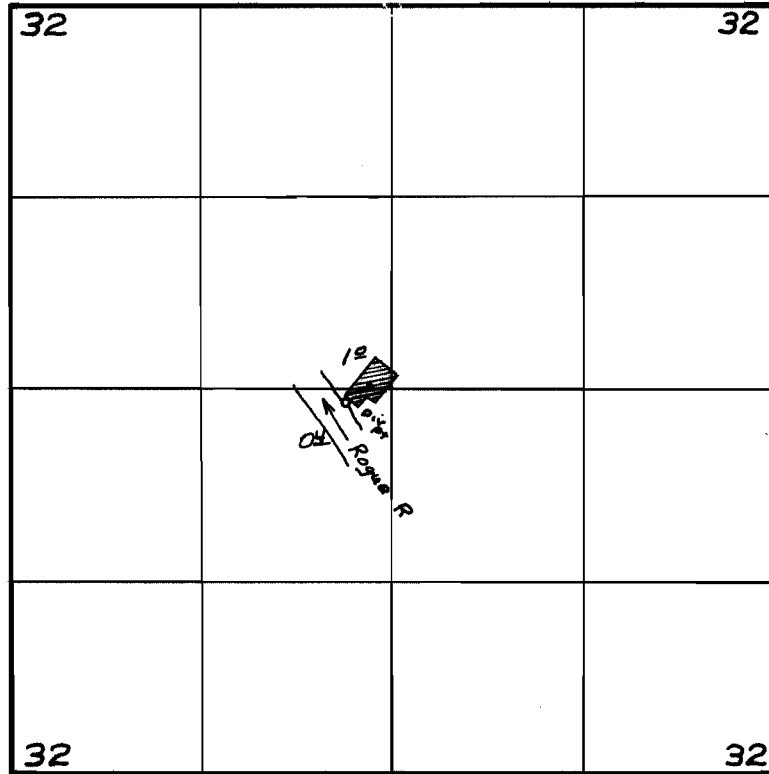

Div Pt located 2720ft S + 320ft W from N-1/4 Cor of Sec 32

## FINAL PROOF SURVEY UNDER

Application No. 39194 Permit No. 29146  
IN NAME OF

Edward R. & Frances Wood Henselman

Surveyed May 18 1967, by W. J. Ruppert