



T.33S.R.2E.W.M.

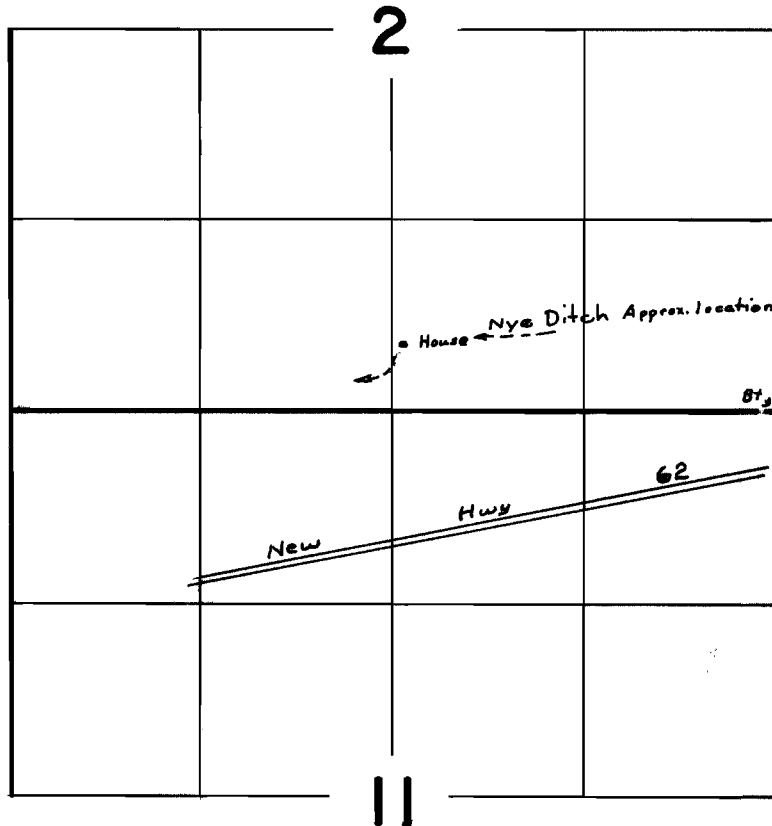

T.32S.R.3E.W.M.

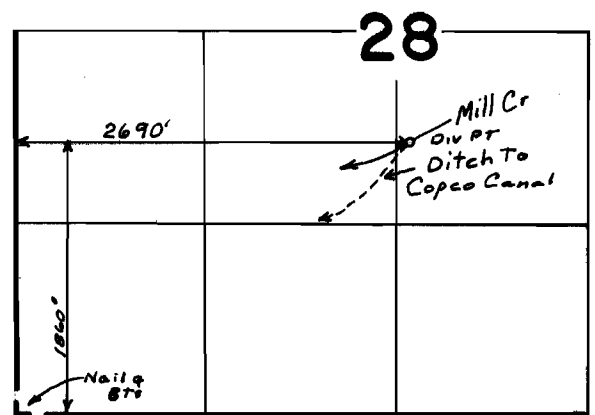

FINAL PROOF SURVEY
UNDER

Application No. 39602 Permit No. 29431
IN NAME OF

Rita G. Pearce

Surveyed May 20, 1967, by W.V. Ruppert.