


T.33S.R.1E.W.M.

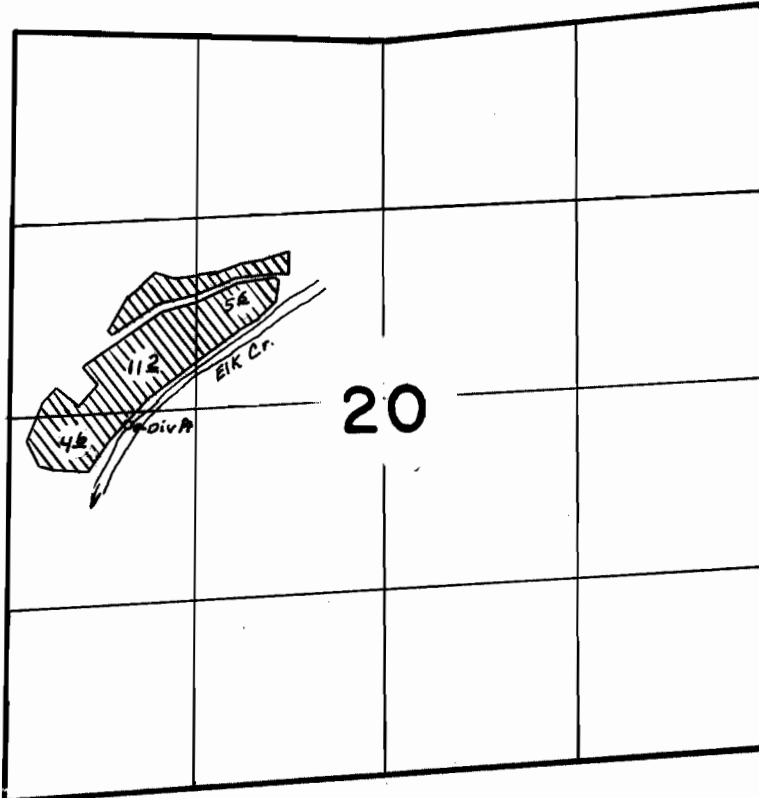

Div PT located 2550ft N + 810ft E from SW Cor Sec 20

FINAL PROOF SURVEY UNDER

Application No. 37927... Permit No. 29500
IN NAME OF

James E. and Nedra M. Joham

Surveyed *May 19, 1967*, by *W.J. Ruppert*