


T.33 S. R. 1 W. W.M.

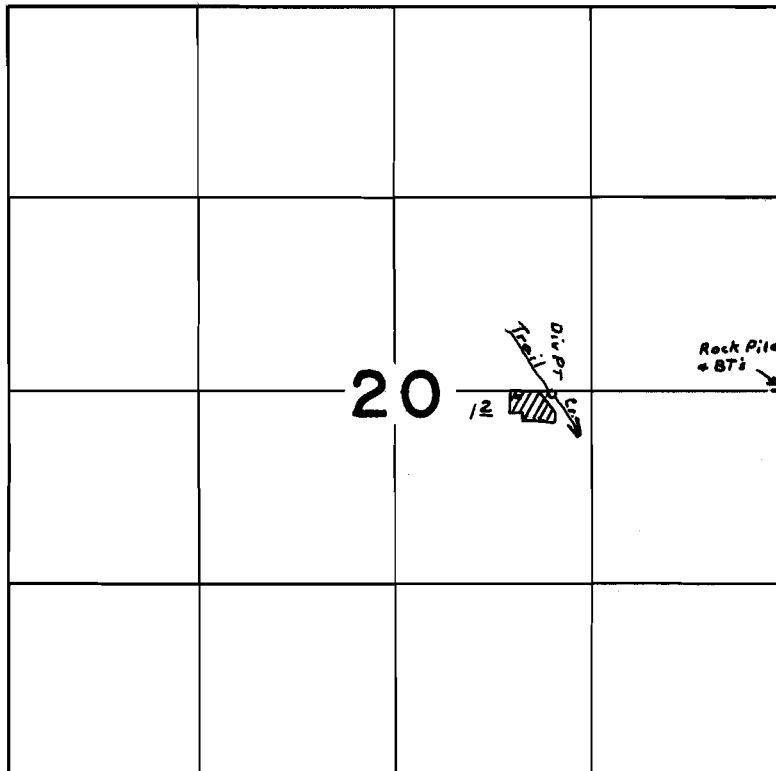

Div Pt located 20ft S and 1590ft W from E 1/4 Cor Sec 20

FINAL PROOF SURVEY UNDER

Application No. 39979 Permit No. 29782
IN NAME OF

Katie C. Ash

Surveyed May 16, 1967, by W. J. Ruppert