


T.33S.R.1W.W.M.

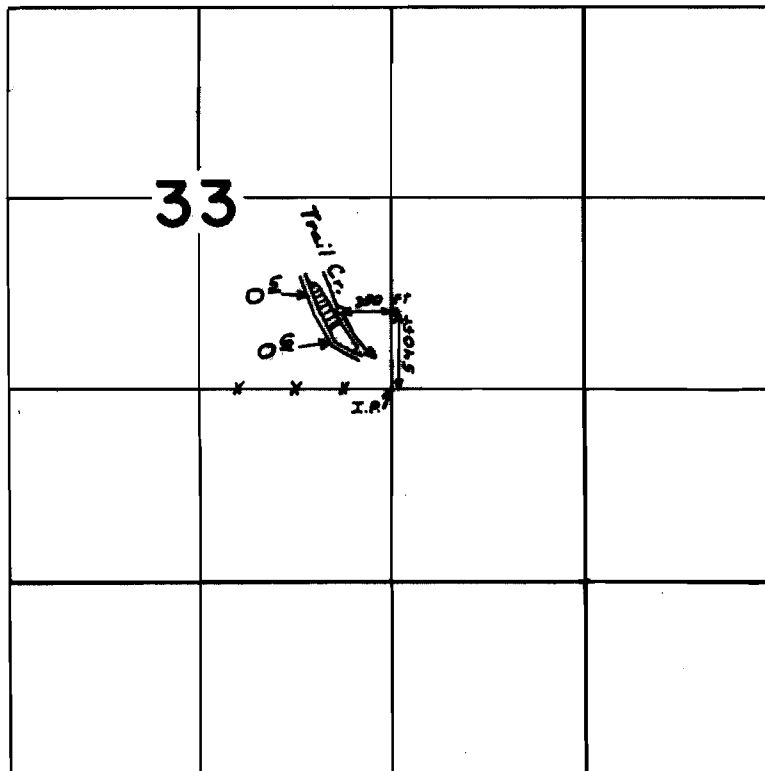

**FINAL PROOF SURVEY**  
UNDER

Application No. ~~40862~~ Permit No. 30461...  
IN NAME OF

*RALPH. J. & JEAN L. HERBST*

Surveyed *May 16*, 1967, by *W. J. Ruppert*