



T.33S.R.2E.W.M.

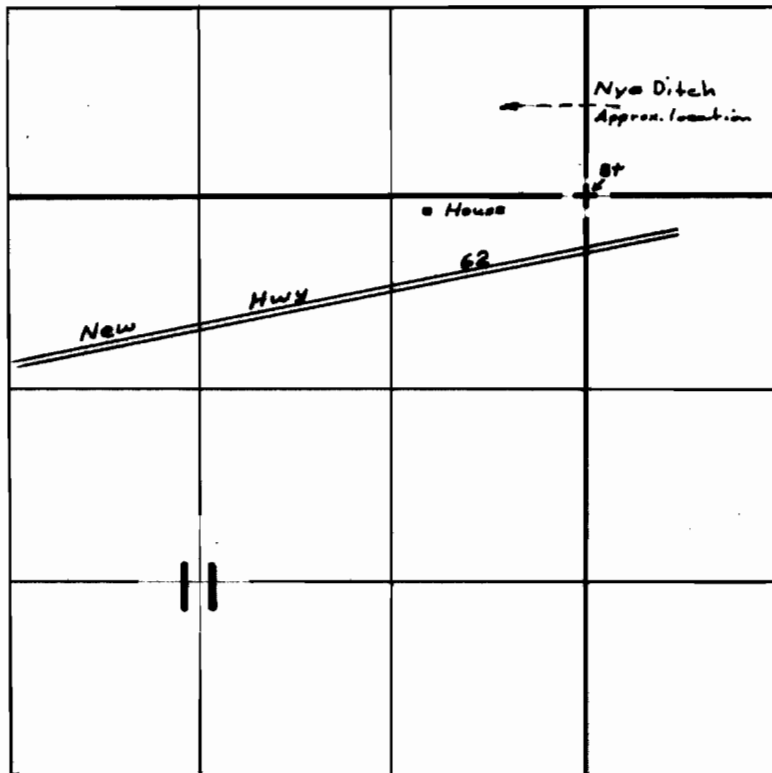

T.32S.R.3E.W.M.

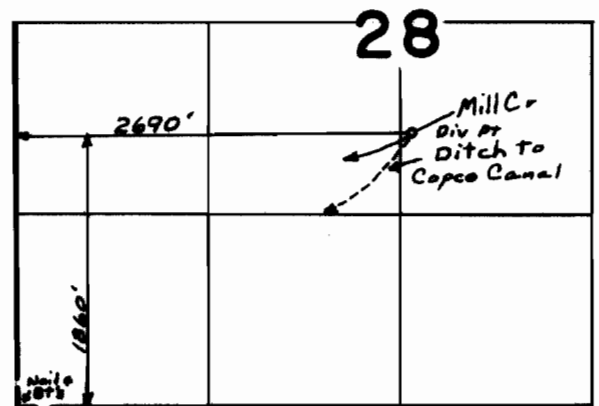

FINAL PROOF SURVEY
UNDER

Application No. 41324 Permit No. 30855
IN NAME OF

Dean & Charlotte Boyer

Surveyed May 20, 1967, by W.J. Ruppert