



T.33S.R.2E.W.M.

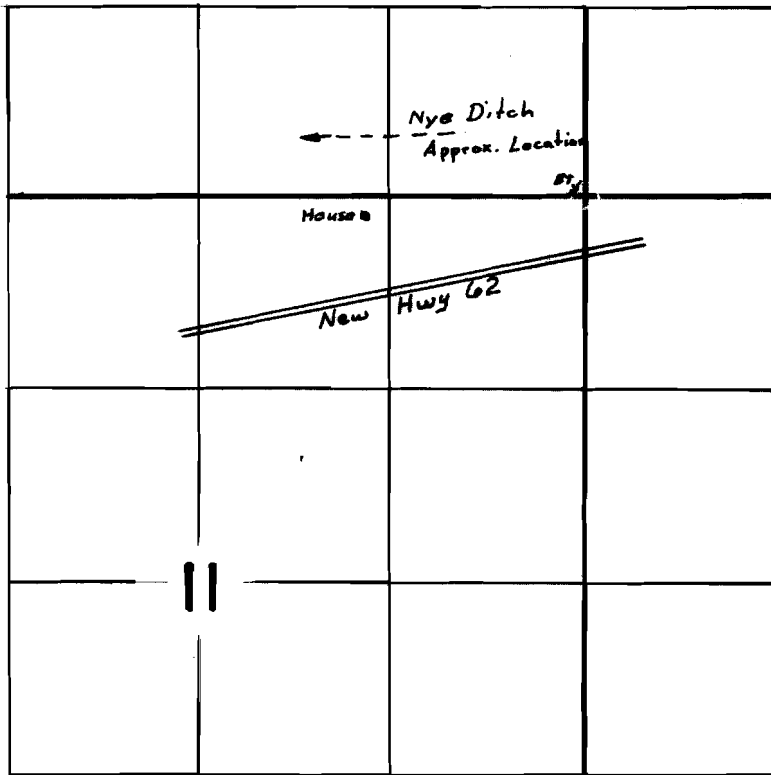

T.32S.R.3E.W.M.

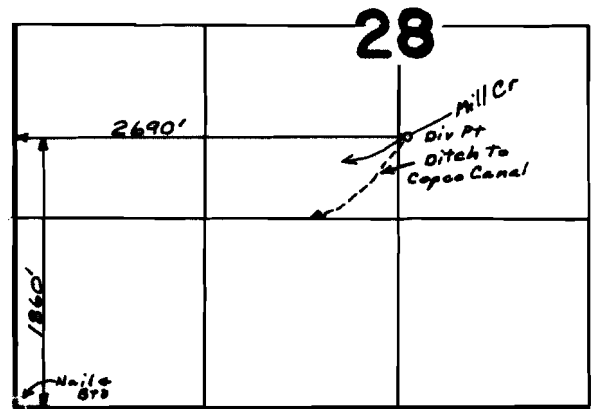

FINAL PROOF SURVEY
UNDER

Application No. 41882... Permit No. 31336...
IN NAME OF

Elton T. Boren

Surveyed May 20, 1967, by *W.J. Ruppert*