


T.39S. R.5W. W.M.

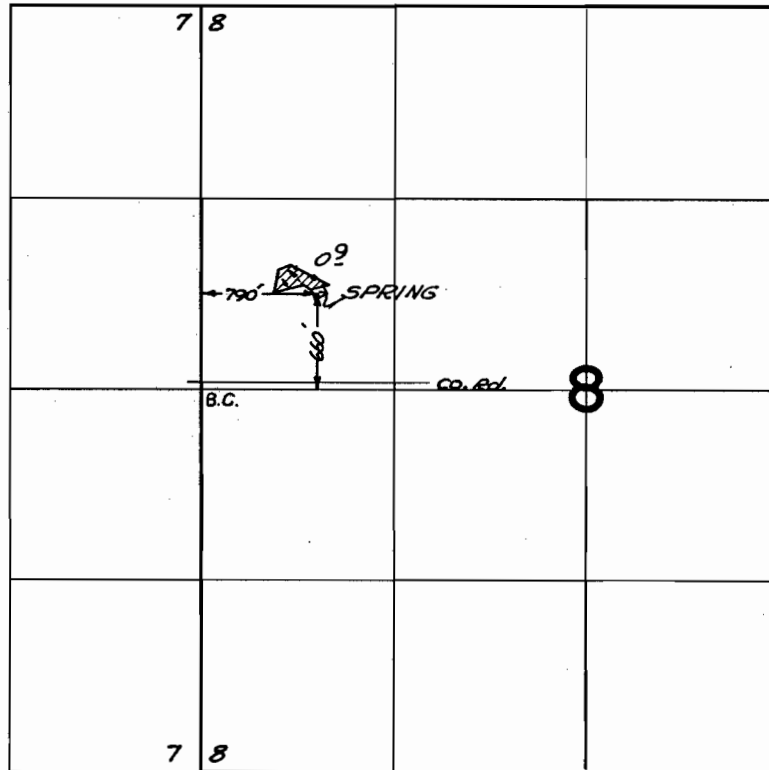

FINAL PROOF SURVEY UNDER

Application No. 38471 Permit No. 28647
IN NAME OF

FRED H. FERBER

Surveyed May 24, 1967, by V. Garner