


# T.39S. R.5W. W.M.

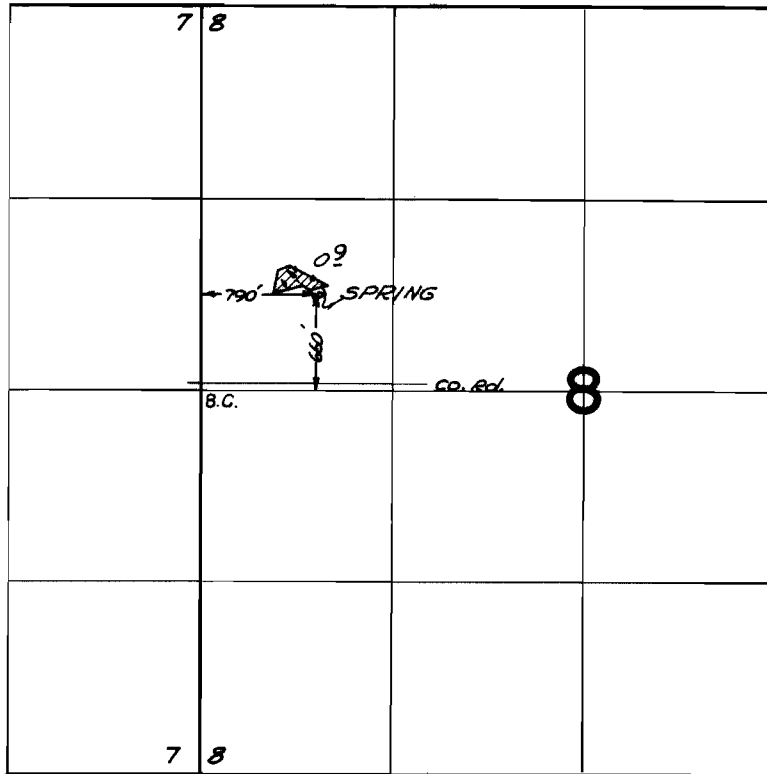

## FINAL PROOF SURVEY UNDER

Application No. 38471 Permit No. 28647  
IN NAME OF

FRED H. FERBER

Surveyed May 24, 1967, by V. Garner