


T.36S. R.12E.W.M.

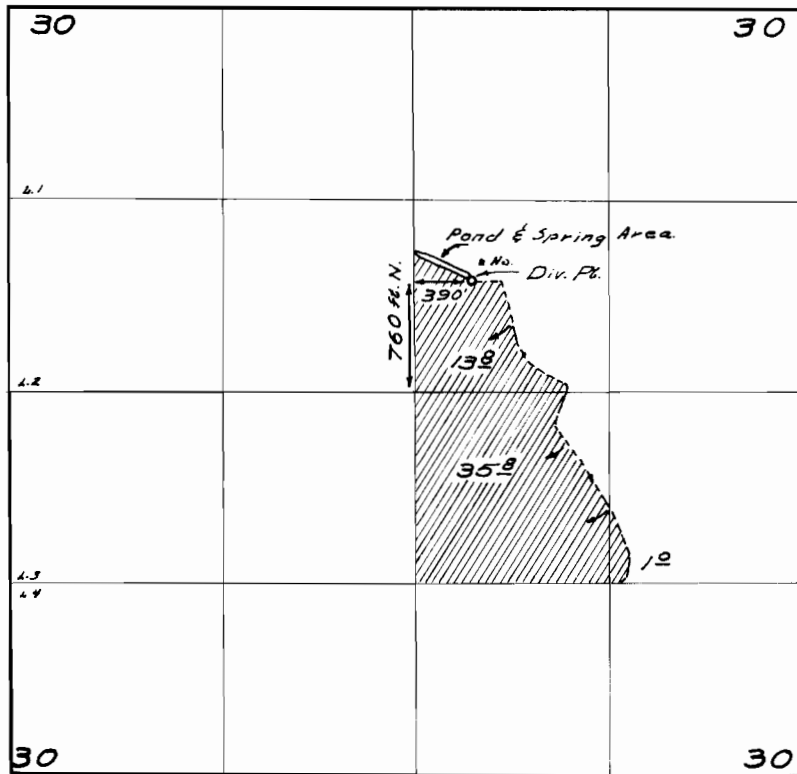

FINAL PROOF SURVEY UNDER

Application No. 32699 Permit No. 25931
IN NAME OF

C. NORMAN PULLIAM

Surveyed Oct. 10 1966, by W. J. Ruppert