


T.36S.R.12E.W.M.

Sprague R. Mose.

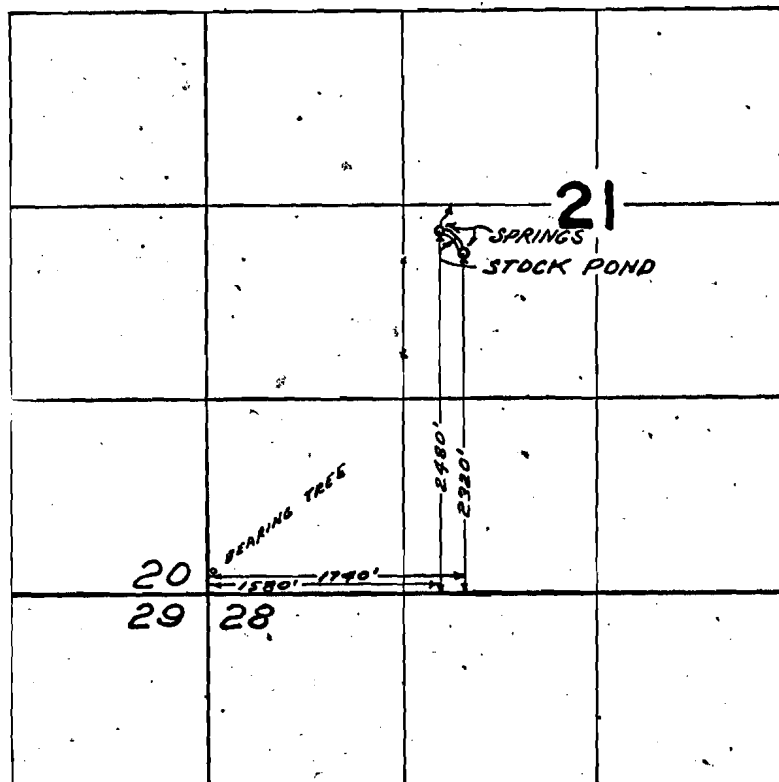

FINAL PROOF SURVEY UNDER

Application No. R-42423 Permit No. R-4761
42424 31341
IN NAME OF

C. NORMAN PULLIAM

Surveyed OCT. 10 1966, by W. J. RUPPERT