


35347

Sprague E. misc.

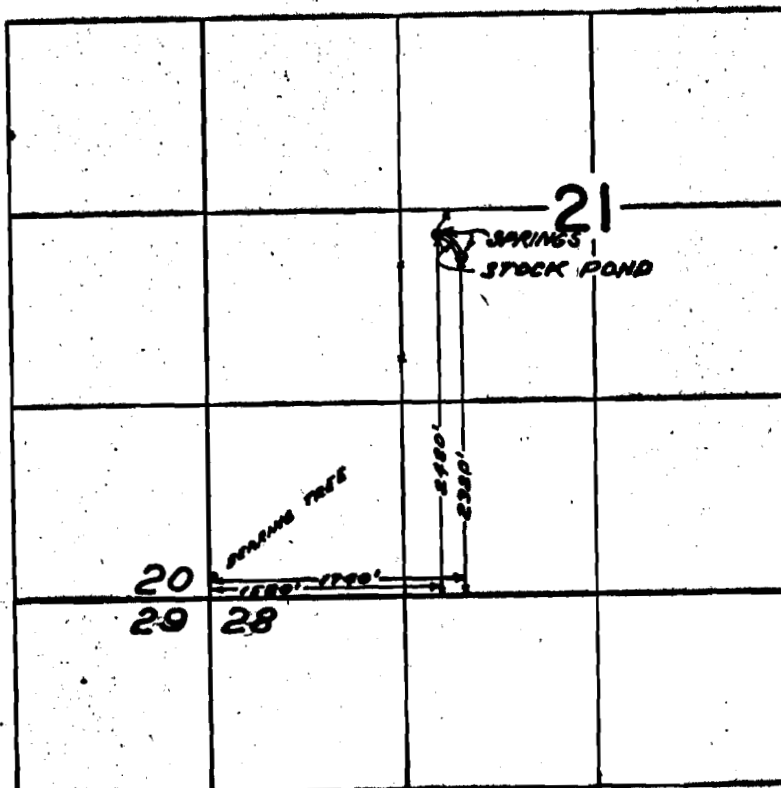

FINAL PROOF SURVEY

UNDER

Application No. R-42423 42424 Permit No. R-4761 31341
IN NAME OF

C. NORMAN PULLIAM

Surveyed OCT. 10 1966, by W. J. RUPPERT