


T.18S.R.2W.W.M.

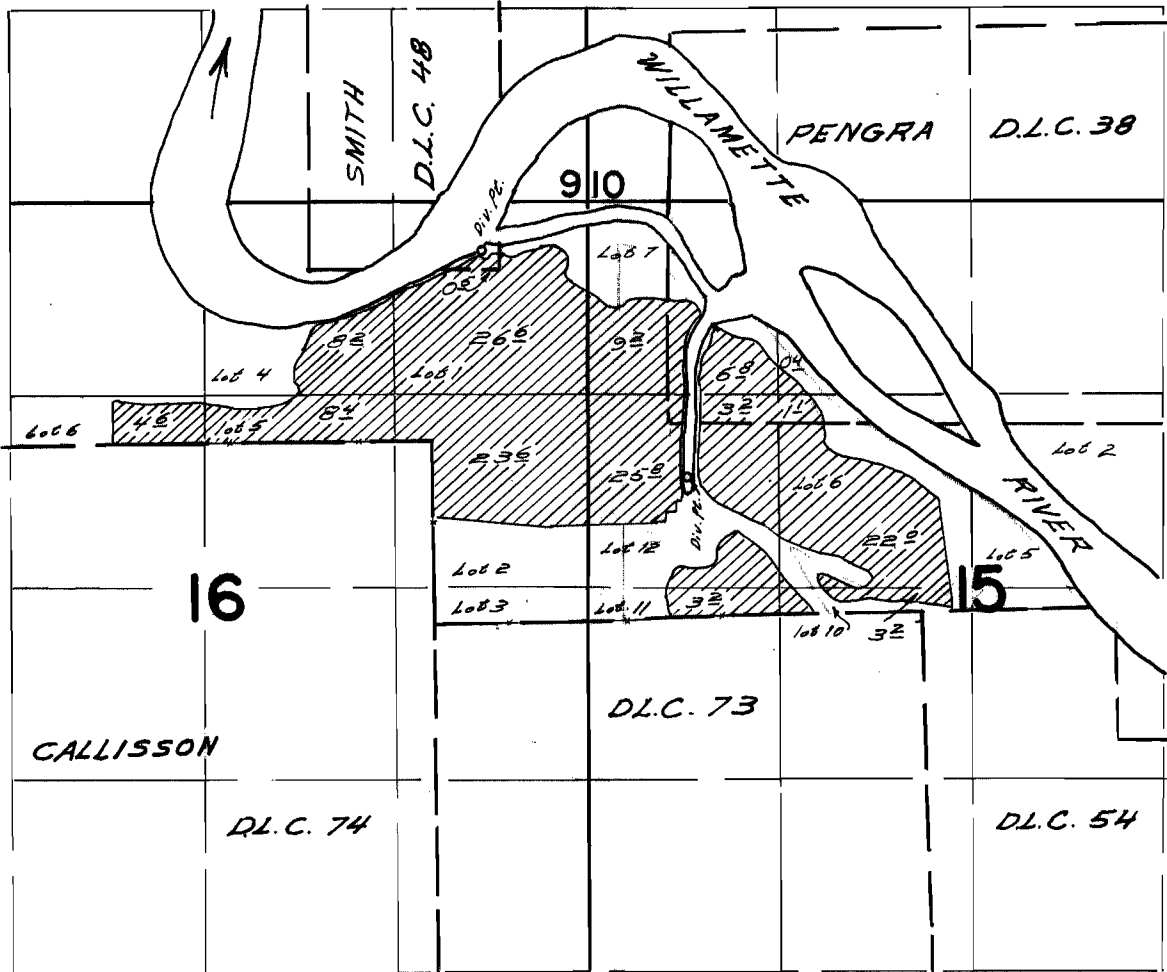

Diversion points located 1310 ft N. & 340 ft E.; & 240 ft S. & 1750 ft E. from N.E. Cor D.L.C. 74

FINAL PROOF SURVEY
UNDER

Application No. 33677 Permit No. 26679
IN NAME OF

Raymond P. Laird

Surveyed May 10, 1966, by T. Garner