


T. 16 S. R. 1 W. W.M.

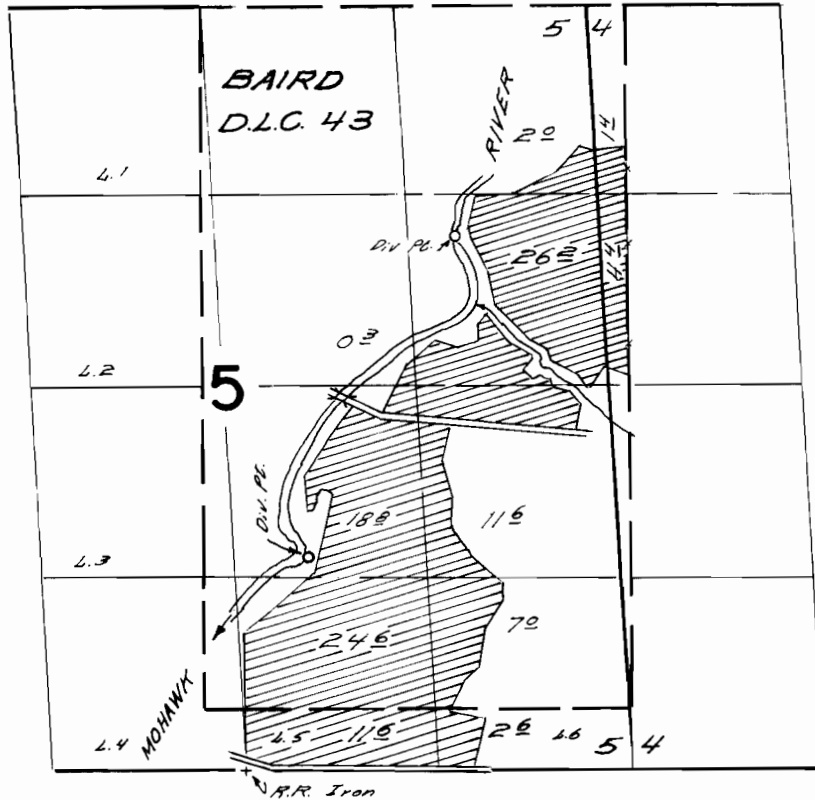

Diversion points located 1450 ft. N. & 430 ft. E., & 3660 ft. N. & 1440 ft. E. from South 1/4 Corner Section 5

FINAL PROOF SURVEY UNDER

Application No. 37389 Permit No. 27830
IN NAME OF

Leland H. Downing

Surveyed Sept. 13 1967, by W. J. Ruppert