


T.18S.R.1W.W.M.

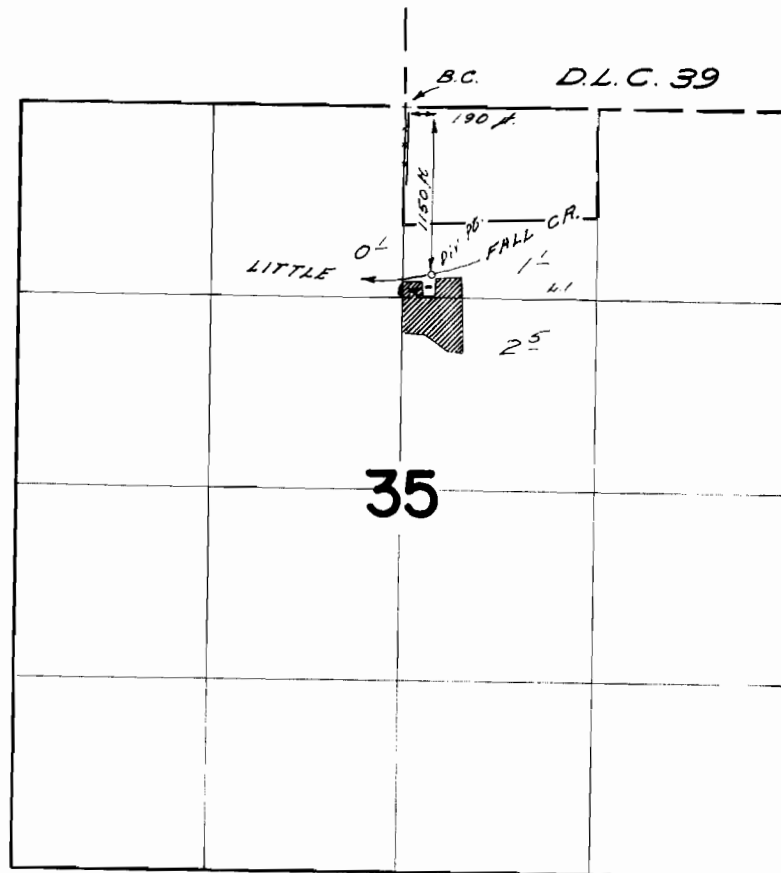

FINAL PROOF SURVEY
UNDER

Application No. 37771 Permit No. 28143
IN NAME OF

WALTER KILE

Surveyed Sept 15 1967, by W. J. Ruppert