


T.16S.R.7 W.W.M.

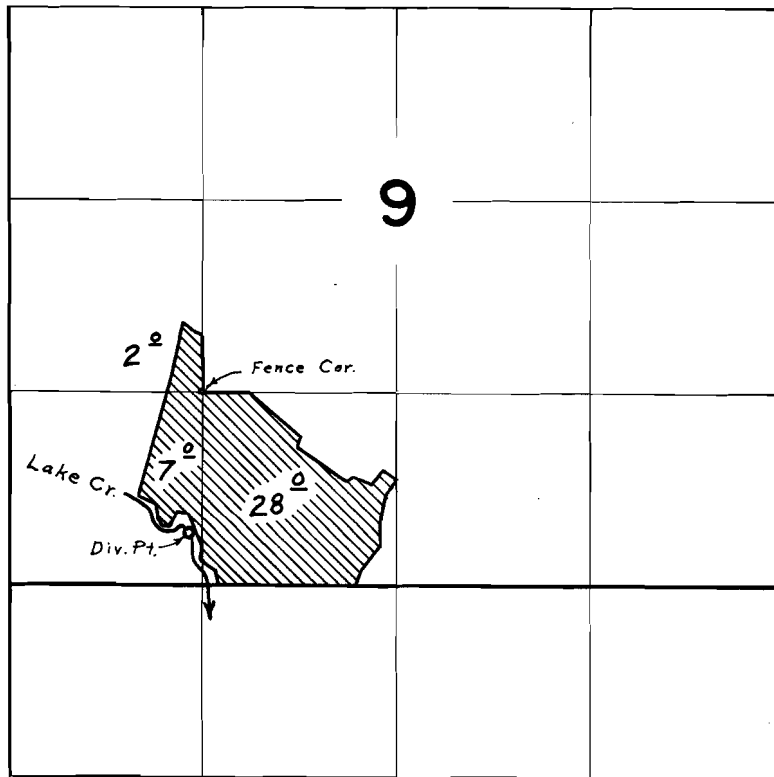

Div. Pt. located 960' S. & 80' W. from the N.E. Cor. S.W. $\frac{1}{4}$, S.W. $\frac{1}{4}$, Sec. 9

FINAL PROOF SURVEY
UNDER

Application No. 40229 Permit No. 30004
IN NAME OF

ROLLIN B. EVANS

Surveyed May 12, 1967, by L. E. Gould