


T.11S. R.3W. W.M.

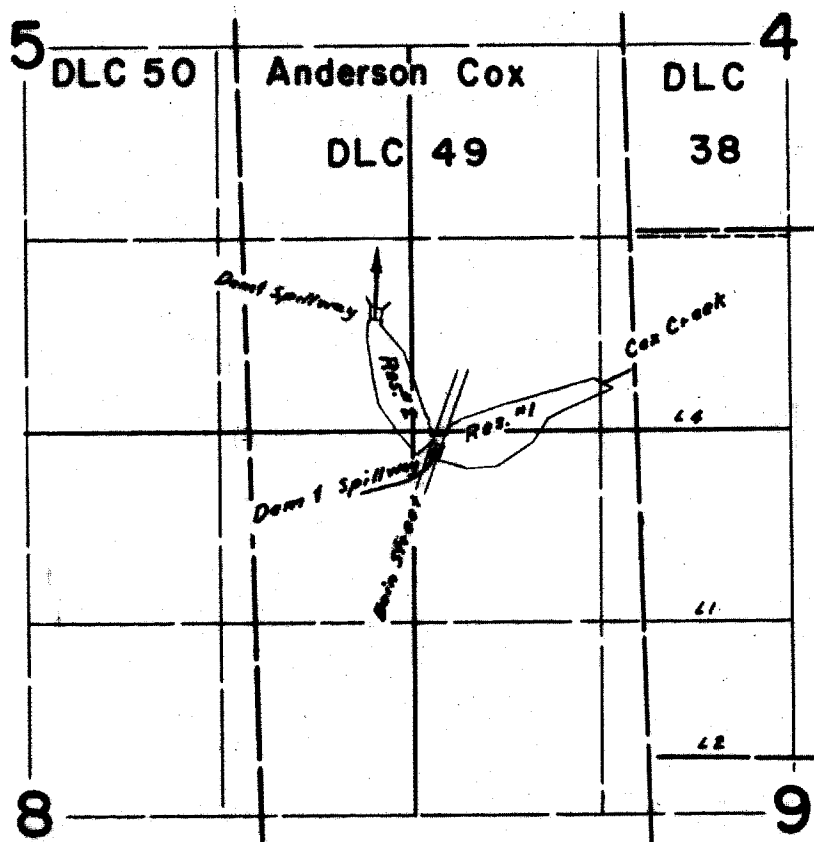

FINAL PROOF SURVEY UNDER

33344

26396

Application No. R-33343. Permit No. R-2282.

IN NAME OF

FREEWAY CONSTRUCTION & DEV. CO.

Surveyed Oct. 15, 1964, by *C.W. Gardner*