


T.I.S.R.I.W.W.M.

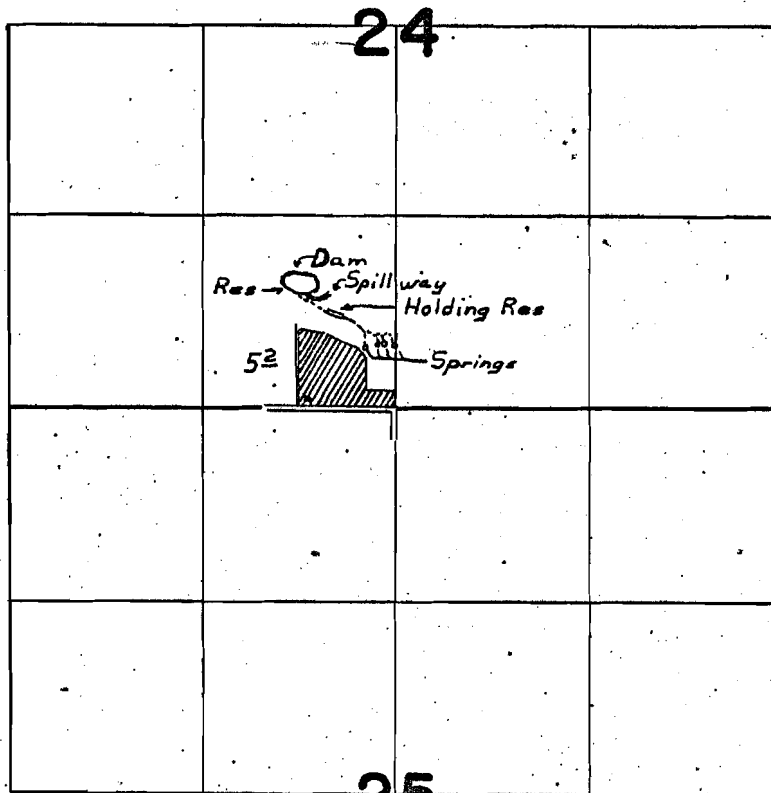

Locations of springs: Ties from S 1/4 Cor of Sec 24
440ft N; 450ft N * 70ft W;
450ft N * 120ft W; 410ft N * 200ft W

FINAL PROOF SURVEY UNDER

Application No. R-33713 - 33714 Permit No. R-2336 26643
IN NAME OF

Leslie E. and Lillie E. Chaney

Surveyed Aug. 8, 1967, by W. H. Ruppert