


# T.I.S.R.I.W.W.M.

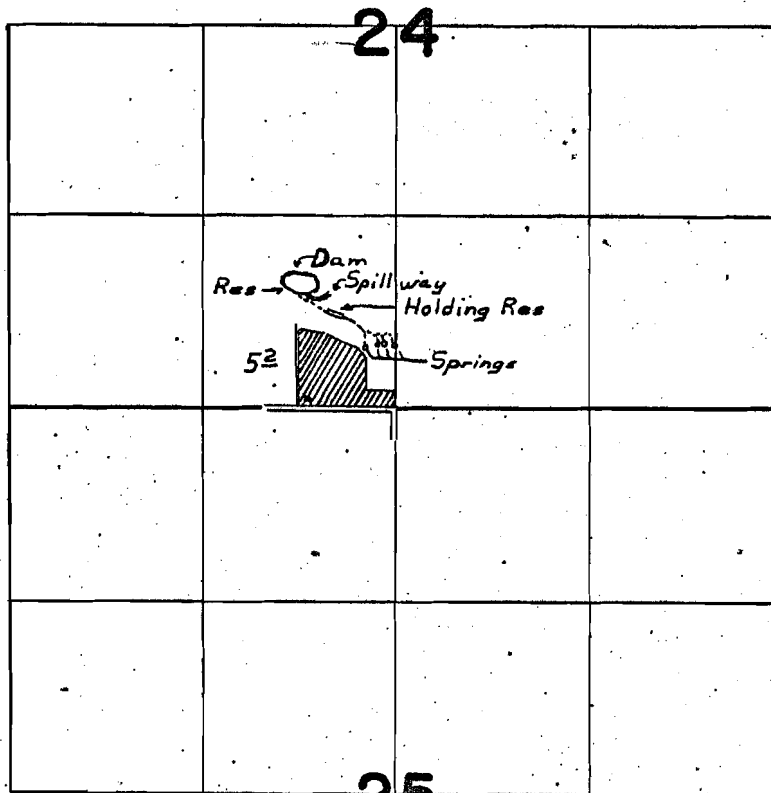

Locations of springs: Ties from S 1/4 Cor of Sec 24  
440ft N; 450ft N \* 70ft W;  
450ft N \* 120ft W; 410ft N \* 200ft W

## FINAL PROOF SURVEY UNDER

Application No. R-33713 - 33714 Permit No. R-2336 26643  
IN NAME OF

Leslie E. and Lillie E. Chaney

Surveyed Aug. 8, 1967, by W. H. Ruppert