


T.10 S.R.2 W. W.M.

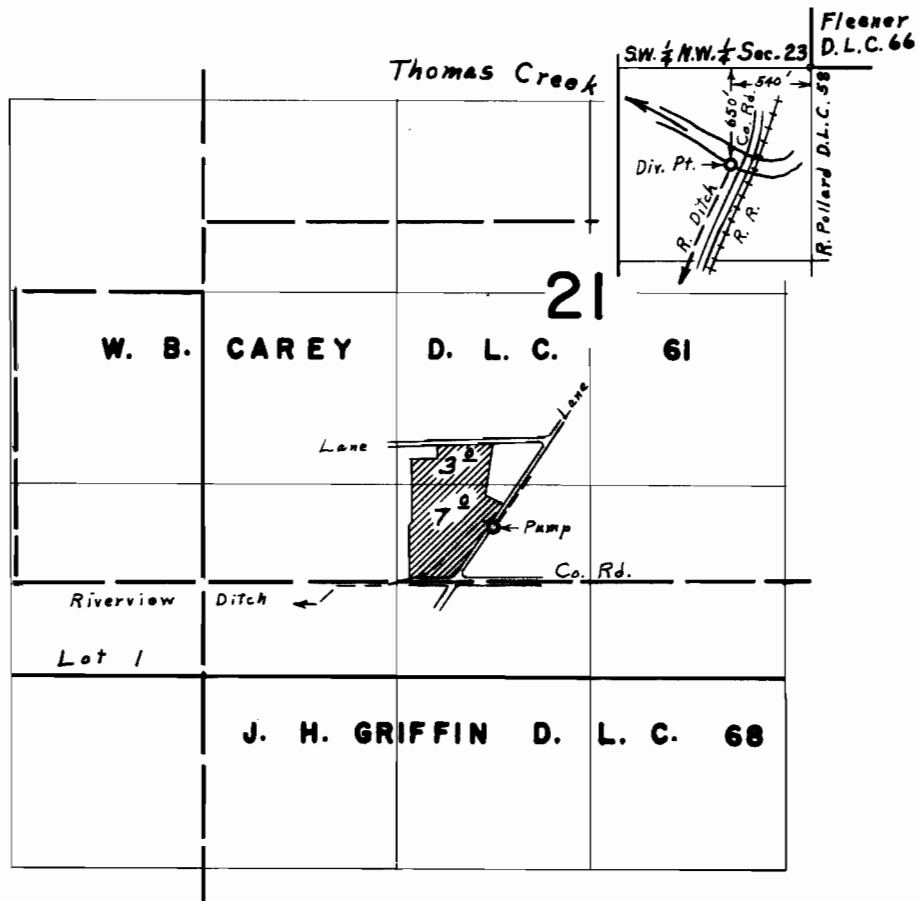

FINAL PROOF SURVEY
UNDER

Application No. 39244 Permit No. 29238
IN NAME OF

RIVERVIEW DITCH ASSOCIATION

Surveyed Nov. 3, 1967, by L. E. Gauld